


1 LOCATION OF WATER WELL: Fraction SE 1/4 NE 1/4 SE 1/4 Section Number 19 Township Number T 8 S Range Number R 10 E

Distance and direction from nearest town or city street address of well if located within city?  
NW corner of Main and Frederick, Tipton, Kansas

2 WATER WELL OWNER: City of Tipton ATTN: A. Arnoldy  
 RR#, St. Address, Box #: Box 127  
 City, State, ZIP Code: Tipton, KS 67485  
 Board of Agriculture, Division of Water Resources  
 Application Number: ---

3 LOCATE WELL'S LOCATION WITH AN "X" IN SECTION BOX: 4 DEPTH OF COMPLETED WELL: 44 ft. ELEVATION: ---

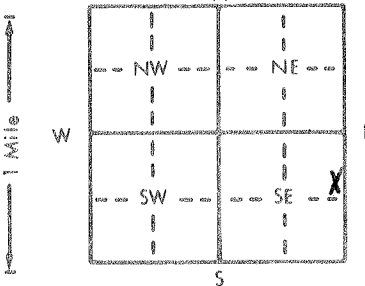

Depth(s) Groundwater Encountered 1. 37 ft. 2. --- ft. 3. --- ft.  
 WELL'S STATIC WATER LEVEL 36.33 ft. below land surface measured on mo/day/yr 11-17-94  
 Pump test data: Well water was --- ft. after --- hours pumping --- gpm  
 Est. Yield --- gpm: Well water was --- ft. after --- hours pumping --- gpm  
 Bore Hole Diameter: 8.625 in. to 44 ft., and --- in. to --- ft.  
 WELL WATER TO BE USED AS:  
 5 Public water supply 8 Air conditioning 11 Injection well  
 1 Domestic 3 Feedlot 6 Oil field water supply 9 Dewatering 12 Other (Specify below)  
 2 Irrigation 4 Industrial 7 Lawn and garden only 10 Monitoring well MW-6  
 Was a chemical/bacteriological sample submitted to Department? Yes --- No X; If yes, mo/day/yr sample was submitted ---  
 Water Well Disinfected? Yes --- No X

5 TYPE OF BLANK CASING USED:  
 1 Steel 3 RMP (SR) 5 Wrought iron 8 Concrete tile CASING JOINTS: Glued --- Clamped ---  
2 PVC 4 ABS 6 Asbestos-Cement 9 Other (specify below) Welded ---  
 7 Fiberglass Threaded X

Blank casing diameter 2 in. to 29 ft., Dia. --- in. to --- ft., Dia. --- in. to --- ft.  
 Casing height above land surface 0 (Flush) in., weight sch. 40 lbs./ft. Wall thickness or gauge No. ---

TYPE OF SCREEN OR PERFORATION MATERIAL:  
 1 Steel 3 Stainless steel 5 Fiberglass 8 RMP (SR) 10 Asbestos-cement  
 2 Brass 4 Galvanized steel 6 Concrete tile 9 ABS 11 Other (specify) ---  
 12 None used (open hole)

SCREEN OR PERFORATION OPENINGS ARE:  
 1 Continuous slot 3 Mill slot 5 Gauzed wrapped 8 Saw cut 11 None (open hole)  
 2 Louvered shutter 4 Key punched 6 Wire wrapped 9 Drilled holes  
 7 Torch cut 10 Other (specify) ---

SCREEN-PERFORATED INTERVALS: From 29 ft. to 44 ft., From --- ft. to --- ft.  
SAND From --- ft. to --- ft., From --- ft. to --- ft.  
GRAVEL PACK INTERVALS: From 26 ft. to 44 ft., From --- ft. to --- ft.

6 GROUT MATERIAL: 1 Neat cement 2 Cement grout 3 Bentonite 4 Other ---  
 Grout Intervals: From 0 ft. to 24 ft., From 24 ft. to 26 ft., From --- ft. to --- ft.

What is the nearest source of possible contamination:  
 1 Septic tank 4 Lateral lines 7 Pit privy 10 Livestock pens 14 Abandoned water well  
 2 Sewer lines 5 Cess pool 8 Sewage lagoon 11 Fuel storage 15 Oil well/Gas well  
 3 Watertight sewer lines 6 Seepage pit 9 Feedyard 12 Fertilizer storage 16 Other (specify below)  
contaminated site  
 Direction from well? --- How many feet? ---

FROM	TO	LITHOLOGIC LOG	FROM	TO	PLUGGING INTERVALS
<u>0</u>	<u>0.5</u>	<u>Asphalt</u>			
<u>0.5</u>	<u>34.5</u>	<u>Silty clay</u>			
<u>34.5</u>	<u>37.0</u>	<u>Clayey gravel</u>			
<u>37.0</u>	<u>44.0</u>	<u>Sandy gravel</u>			
<u>44.0</u>	<u>TD</u>				

**FLUSH MOUNT WAIVER**  
09-26-94  
**DON TAYLOR**

7 CONTRACTOR'S OR LANDOWNER'S CERTIFICATION: This water well was (1) constructed (2) reconstructed, or (3) plugged under my jurisdiction and was completed on (mo/day/year) 10-25-94 and this record is true to the best of my knowledge and belief. Kansas Water Well Contractor's License No. 479 This Water Well Record was completed on (mo/day/yr) 11-21-94 under the business name of EBBERTS DRILLING by (signature) Arizon Ebberts