


1 LOCATION OF WATER WELL: County: Mitchell Fraction SE 1/4 SW 1/4 SW 1/4 Section Number 20 Township Number T 8 S Range Number R 10 EW

Distance and direction from nearest town or city street address of well if located within city?  
Farmway Coop 108 Washington, Tipton, Kansas

2 WATER WELL OWNER: RR#, St. Address, Box # Farmway Coop Board of Agriculture, Division of Water Resources  
 City, State, ZIP Code 108 Washington, Tipton, Kansas 67485 Application Number: -----

3 LOCATE WELL'S LOCATION WITH AN "X" IN SECTION BOX:

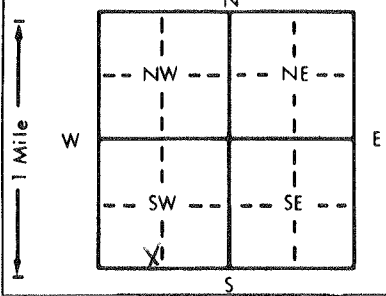

4 DEPTH OF COMPLETED WELL: 35 ft. ELEVATION: 27.7 ft.  
 Depth(s) Groundwater Encountered 29.23 ft. 2. 27.7 ft. 3. ----- ft.  
 WELL'S STATIC WATER LEVEL 29.23 ft. below land surface measured on mo/day/yr 4/20/95  
 Pump test data: Well water was ----- ft. after ----- hours pumping ----- gpm  
 Est. Yield ----- gpm; Well water was ----- ft. after ----- hours pumping ----- gpm  
 Bore Hole Diameter 8.625 in. to 35 ft., and ----- in. to ----- ft.  
 WELL WATER TO BE USED AS:  
 5 Public water supply 8 Air conditioning 11 Injection well  
 1 Domestic 3 Feedlot 6 Oil field water supply 9 Dewatering 12 Other (Specify below)  
 2 Irrigation 4 Industrial 7 Lawn and garden only 10 Monitoring well  
 Was a chemical/bacteriological sample submitted to Department? Yes ----- No X; If yes, mo/day/yr sample was submitted -----  
 Water Well Disinfected? Yes ----- No X

5 TYPE OF BLANK CASING USED:  
 1 Steel 3 RMP (SR) 5 Wrought iron 8 Concrete tile CASING JOINTS: Glued ----- Clamped -----  
2 PVC 4 ABS 6 Asbestos-Cement 9 Other (specify below) Welded -----  
 7 Fiberglass Threaded X  
 Blank casing diameter 2 in. to 25 ft., Dia ----- in. to ----- ft., Dia ----- in. to ----- ft.  
 Casing height above land surface 0 in., weight SCH 40 PVC lbs./ft. Wall thickness or gauge No. -----  
 TYPE OF SCREEN OR PERFORATION MATERIAL:  
 1 Steel 3 Stainless steel 5 Fiberglass 8 RMP (SR) 10 Asbestos-cement  
 2 Brass 4 Galvanized steel 6 Concrete tile 9 ABS 11 Other (specify) -----  
 12 None used (open hole)  
 SCREEN OR PERFORATION OPENINGS ARE:  
 1 Continuous slot 3 Mill slot 5 Gauzed wrapped 8 Saw cut 11 None (open hole)  
 2 Louvered shutter 4 Key punched 6 Wire wrapped 9 Drilled holes  
 7 Torch cut 10 Other (specify) -----  
 SCREEN-PERFORATED INTERVALS: From 25 ft. to 35 ft., From ----- ft. to ----- ft.  
Sand From ----- ft. to ----- ft., From ----- ft. to ----- ft.  
 GRAVEL PACK INTERVALS: From 18 ft. to 35 ft., From ----- ft. to ----- ft.  
 From ----- ft. to ----- ft., From ----- ft. to ----- ft.

6 GROUT MATERIAL: 1 Neat cement 2 Cement grout 3 Bentonite 4 Other  
 Grout Intervals: From 0 ft. to 16 ft., From 16 ft. to 18 ft., From ----- ft. to ----- ft.  
 What is the nearest source of possible contamination:  
 1 Septic tank 4 Lateral lines 7 Pit privy 10 Livestock pens 14 Abandoned water well  
 2 Sewer lines 5 Cess pool 8 Sewage lagoon 11 Fuel storage 15 Oil well/Gas well  
 3 Watertight sewer lines 6 Seepage pit 9 Feedyard 12 Fertilizer storage 16 Other (specify below)  
 13 Insecticide storage Contaminated site  
 Direction from well? ----- How many feet? -----

FROM	TO	LITHOLOGIC LOG	FROM	TO	PLUGGING INTERVALS
GL	1.00	Soil			
1.00	23.00	Silty Clay			
23.00	27.00	Clayey Gravel			
27.00	28.00	Possible Shale			
28.00	35.00	Clayey Gravel			
35.00	TD	End of Borehole			

7 CONTRACTOR'S OR LANDOWNER'S CERTIFICATION: This water well was (1) constructed, (2) reconstructed, or (3) plugged under my jurisdiction and was completed on (mo/day/year) 4/20/95 and this record is true to the best of my knowledge and belief. Kansas Water Well Contractor's License No. 585 This Water Well Record was completed on (mo/day/yr) 5/3/95 under the business name of Associated Environmental, Inc. by (signature) D. Johnson for Karen Duncan