


2 WATER WELL OWNER: Osborne County Landfill		
RR#, St. Address, Box # :		Board of Agriculture, Division of Water Resources
City, State, ZIP Code :	Osborne, Ks 67473	MW-3
		Application Number:

4	DEPTH OF COMPLETED WELL	70	ft. ELEVATION:
---	-------------------------	----	----------------

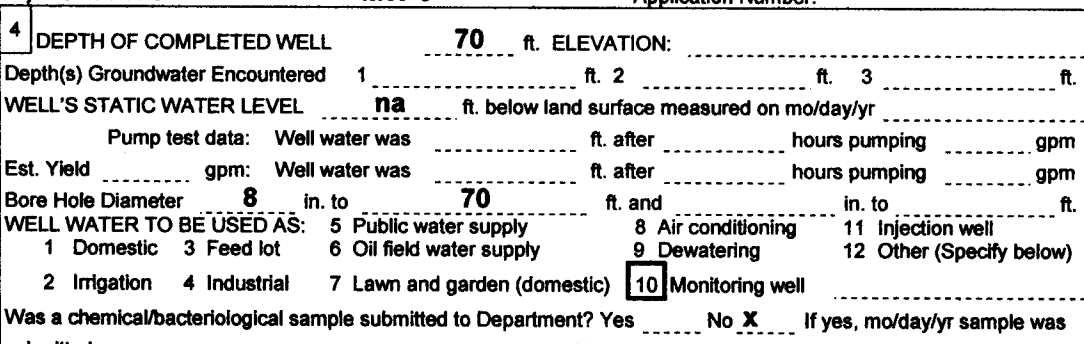

Blank casing diameter **2** in. to **35** ft., Dia _____ in. to _____ ft., Dia _____ in. to _____ ft.
Casing height above land surface **0** in., weight **.716** lbs./ft. Wall thickness or gauge No. **.154**

SCREEN OR PERFORATION OPENINGS ARE:			5 Gauzed wrapped	<div style="border: 1px solid black; padding: 2px;">8</div> Saw cut	11 None (open hole)
1 Continuous slot	3 Mill slot	6 Wire wrapped	9 Drilled holes		
2 Louvered shutter	4 Key punched	7 Torch cut	10 Other (specify)		

SCREEN-PERFORATED INTERVALS:	From	25	ft. to	35	ft. From		ft. to		ft.
	From		ft. to		ft. From		ft. to		ft.
GRAVEL PACK INTERVALS:	From	23	ft. to	25	ft. From		ft. to		ft.
	From		ft. to		ft. From		ft. to		ft.

6 GROUT MATERIAL: 1 Neat cement 2 Cement grout **3 Bentonite** 4 Other _____
Grout Intervals From 0 ft. to 23 ft. From _____ ft. to _____ ft. From _____ ft. to _____ ft.
What is the nearest source of possible contamination: _____

1 Septic tank	4 Lateral lines	7 Pit privy	10 Livestock pens	14 Abandoned water well
2 Sewer lines	5 Cess pool	8 Sewage lagoon	11 Fuel storage	15 Oil well/ Gas well
3 Watertight sewer lines	6 Seepage pit	9 Feedyard	12 Fertilizer storage	16 Other (specify below)
			13 Insecticide storage	Contaminated site

Direction from well? _____ How many feet? _____

FROM	TO	CODE	LITHOLOGIC LOG	FROM	TO	PLUGGING INTERVALS
0	8		Weathered shale, some Sandstone & limestone Fragments			
8	12		Slightly weathered shale			
12	70		Competent blue shale			
			Original log was lost, re-logged On 2-18-03.			
			Scott Shields, KDHE, witness			

7 CONTRACTOR'S OR LANDOWNER'S CERTIFICATION: This water well was (1) constructed, (2) reconstructed, or (3) plugged under my jurisdiction and was completed on (mo/day/yr) 3-10-99 and this record is true to the best of my knowledge and belief. Kansas Water Well Contractor's License No. 554 This Water Well Record was completed on (mo/day/yr) 3-26-03 under the business name of Woofter Pump and Well Inc. by (signature) [Signature]