USE TYPEWRITER OR BALL POINT PEN-PRESS FIRMLY, PRINT CLEARLY.

WATER WELL RECORD
KSA 82a-1201-1215

Kansas Department of Health and Environment-Division of Environment
(Water well Contractors)
Topeka, Kansas 66620

1. Location of well:	County: Osborne	Fraction: SE 1/4 1/4 1/4	Section number: 32	Township number: T 8 S	Range number: R 13 E/W

2. Distance and direction from nearest town or city: 2 1/4 Mile North of Culvert West Side
Street address of well location if in city:

3. Owner of well: Clinton Grieve
R.R. or street: R.F.D.
City, state, zip code: Osborne, Kansas

4. Locate with "X" in section below:

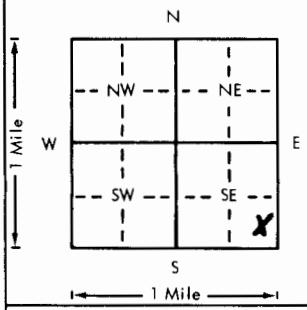

Sketch map:

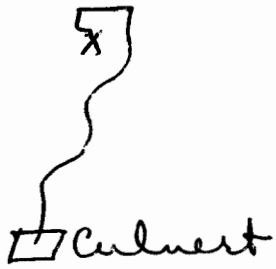

5. Type and color of material	From	To
Dark Brown Clay	0	18
Light Brown Clay & Gravel	18	40

(Use a second sheet if needed)

6. Bore hole dia. 8 1/2 in. Completion date 10/30/79
Well depth 40 ft.

7. X Cable tool __ Rotary __ Driven __ Dug
__ Hollow rod __ Jetted __ Bored __ Reverse rotary

8. Use: __ Domestic __ Public supply __ Industry
__ Irrigation __ Air conditioning X Stock
__ Lawn __ Oil field water __ Other

9. Casing: Material _____ Height: Above or below
Threaded ____ Welded ____ Surface 18 in.
RMP ____ PVC X Weight 2.83 lbs./ft.
Dia. 5 in. to 40 ft. depth Wall Thickness: inches or
Dia. ____ in. to ____ ft. depth gage No. .265

10. Screen: Manufacturer's name MPI
Type PVC Dia. 5"
Slot/gauze .025 Length 10'
Set between 30 ft. and 40 ft.
____ ft. and ____ ft.
Gravel pack? X Size range of material 3/16 x 3/8

11. Static water level: mo./day/yr.
12 ft. below land surface Date 10/30/79

12. Pumping level below land surfaces:
____ ft. after ____ hrs. pumping ____ g.p.m.
____ ft. after ____ hrs. pumping ____ g.p.m.
Estimated maximum yield 50 g.p.m.

13. Water sample submitted: mo./day/yr.
__ Yes X No Date

14. Well head completion:
X Pitless adapter ____ Inches above grade

15. Well grouted? X
With: X Neat cement ____ Bentonite ____ Concrete
Depth: From 5 ft. to 17 ft.

16. Nearest source of possible contamination: None
ft. ____ Direction ____ Type ____
Well disinfected upon completion? X Yes ____ No

17. Pump: Not installed
Manufacturer's name F+W
Model number ____ HP 1/2 Volts 230
Length of drop pipe 35 ft. capacity 10 g.p.m.
Type:
X Submersible ____ Turbine
____ Jet ____ Reciprocating
____ Centrifugal ____ Other

18. Elevation:

Topography:
____ Hill
____ Slope
____ Upland
X Valley

19. Remarks:

20. Water well contractor's certification:
This well was drilled under my jurisdiction and this report is true to the best of my knowledge and belief.
Small's Water Well 360
Business name License No.
Address 95 South KS
Signed William L. Wagner Date 12/12/79
Authorized representative

T 8 R 13 (W) E Sec 32 1/4 SE 1/4 1/4 1/4

Forward the white, blue and pink copies to the Department of Health and Environment

Form WWC-5

MI-1023