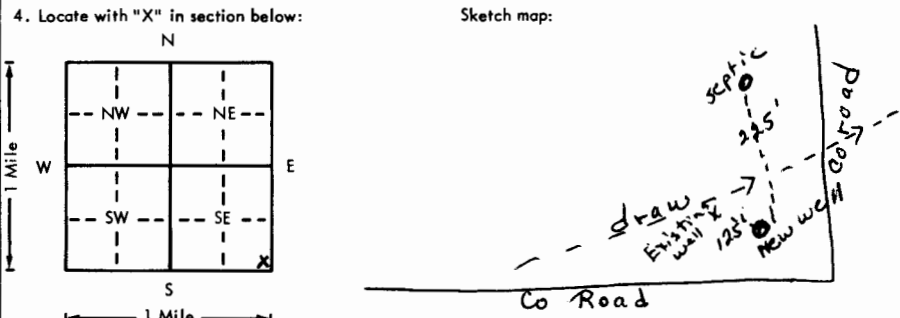


USE TYPEWRITER OR BALL POINT PEN-PRESS FIRMLY, PRINT CLEARLY.

WATER WELL RECORD
KSA 82a-1201-1215

Kansas Department of Health and Environment-Division of Environment
(Water well Contractors)
Topeka, Kansas 66620

1. Location of well:	County Osborne	Fraction SE 1/4 SE 1/4 SE 1/4	Section number 3	Township number T 8 S R 15	Range number EW
2. Distance and direction from nearest town or city: 1 mile West, 6 mile South of Street address of well location if in city: Alton, Kansas			3. Owner of well: Stanley Roach R.R. or street: City, state, zip code: Alton, Kansas		
4. Locate with "X" in section below: 			6. Bore hole dia. 11 in. Completion date 1-2-79 Well depth 25 ft.		
5. Type and color of material			7. <input checked="" type="checkbox"/> Cable tool <input checked="" type="checkbox"/> Rotary <input type="checkbox"/> Driven <input type="checkbox"/> Dug <input type="checkbox"/> Hollow rod <input type="checkbox"/> Jetted <input type="checkbox"/> Bored <input type="checkbox"/> Reverse rotary		
Soil			8. Use: <input type="checkbox"/> Domestic <input type="checkbox"/> Public supply <input type="checkbox"/> Industry <input type="checkbox"/> Irrigation <input type="checkbox"/> Air conditioning <input checked="" type="checkbox"/> Stock <input type="checkbox"/> Lawn <input type="checkbox"/> Oil field water <input type="checkbox"/> Other		
Post Rock Gravel			9. Casing: Material pit Height: Above or below Threaded <input type="checkbox"/> Welded <input checked="" type="checkbox"/> Surface 2 1/2 in. RMP <input type="checkbox"/> PVC <input checked="" type="checkbox"/> Height 3.58 lbs./ft. Dia. 6 in. to 15 ft. depth Wall Thickness: inches or <input checked="" type="checkbox"/> Dia. 6 in. to 15 ft. depth Gauge No. 0325		
Solid Post Rock			10. Screen: Manufacturer's name Stockton MPI Type PVC RMP Dia. 6" Slot/gauze 1/16 Length 6" Set between 15' ft. and 25' ft. Gravel pack? <input checked="" type="checkbox"/> yes Size range of material 1/8-3/16		
Yellow Clay			11. Static water level: 12' 6" mo./day/yr. 12' 6" ft. below land surface Date 1-2-79		
Medium to very large post rock gravel			12. Pumping level below land surfaces: 12 ft. after 1 hrs. pumping 20 g.p.m. 12 ft. after 1 hrs. pumping 20 g.p.m. Estimated maximum yield 250 g.p.m.		
Blue shale			13. Water sample submitted: 12/27/79 mo./day/yr. Yes <input type="checkbox"/> No <input checked="" type="checkbox"/> Date		
			14. Well head completion: <input type="checkbox"/> Pitless adapter 24 inches above grade		
			15. Well grouted? yes With: <input checked="" type="checkbox"/> Neat cement <input type="checkbox"/> Bentonite <input checked="" type="checkbox"/> Concrete Depth: From 0 ft. to 10 ft.		
			16. Nearest source of possible contamination: ft. 22.5 Direction north Type septic Well disinfected upon completion? <input type="checkbox"/> Yes <input checked="" type="checkbox"/> No		
			17. Pump: <input checked="" type="checkbox"/> Not installed Manufacturer's name _____ HP _____ Volts _____ Length of drop pipe _____ ft. capacity _____ g.p.m. Type: <input type="checkbox"/> Submersible <input type="checkbox"/> Turbine <input type="checkbox"/> Jet <input type="checkbox"/> Reciprocating <input type="checkbox"/> Centrifugal <input type="checkbox"/> Other		
18. Elevation:			20. Water well contractor's certification: This well was drilled under my jurisdiction and this report is true to the best of my knowledge and belief. JRW Water Service 327 Business name License No. Address Rt. #1, Stockton, Ks. Signed Wesley Jackson Date 2-9-79 Authorized representative		
19. Remarks: Owner know a 4' x 4' cement slab @ ground level is a state law Stanley Roach					

Forward the white, blue and pink copies to the Department of Health and Environment

Form WWC-5