


MW-10

1 LOCATION OF WATER WELL: County: Rooks Fraction: NW 1/4 SW 1/4 SW 1/4 Section Number: 29 Township, Number: T 8 S Range Number: R 17 EW

Distance and direction from nearest town or city street address of well if located within city?  
from Hwy 183 + 18, 6 miles N, 2.57 E, .5 N on lease road, to alfalfa field

2 WATER WELL OWNER: KCC Bruce Basor  
 RR#, St. Address, Box #: 2301 E 13th Street Board of Agriculture, Division of Water Resources  
 City, State, ZIP Code: Hays, KS 67601 Application Number:

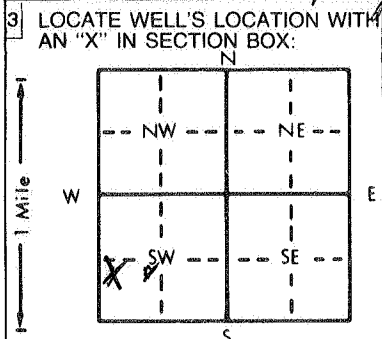

4 DEPTH OF COMPLETED WELL: 24 ft. ELEVATION: -  
 Depth(s) Groundwater Encountered: 1 25 ft. 2. - ft. 3. - ft.  
 WELL'S STATIC WATER LEVEL: 4.18 ft. below land surface measured on 5/4/98  
 Pump test data: Well water was - ft. after - hours pumping - gpm  
 Est. Yield - gpm; Well water was - ft. after - hours pumping - gpm  
 Bore Hole Diameter: 6" in. to 24 ft., and - in. to - ft.  
 WELL WATER TO BE USED AS:  
 1 Domestic 3 Feedlot 6 Oil field water supply 9 Dewatering 12 Other (Specify below)  
 2 Irrigation 4 Industrial 7 Lawn and garden only 10 Monitoring well MW-10  
 Was a chemical/bacteriological sample submitted to Department? Yes - No X; If yes, mo/day/yr sample was submitted  
 Water Well Disinfected? Yes - No X

5 TYPE OF BLANK CASING USED:  
 1 Steel 3 RMP (SR) 5 Wrought iron 8 Concrete tile CASING JOINTS: Glued - Clamped -  
 2 PVC 4 ABS 6 Asbestos-Cement 9 Other (specify below) Welded -  
 7 Fiberglass Threaded X  
 Blank casing diameter: 2' in. to 12 ft., Dia - in. to - ft., Dia - in. to - ft.  
 Casing height above land surface: 71.5 in., weight 3CH 40 lbs./ft. Wall thickness or gauge No. -  
 TYPE OF SCREEN OR PERFORATION MATERIAL:  
 1 Steel 3 Stainless steel 5 Fiberglass 8 RMP (SR) 10 Asbestos-cement  
 2 Brass 4 Galvanized steel 6 Concrete tile 9 ABS 11 Other (specify) -  
 12 None used (open hole)  
 SCREEN OR PERFORATION OPENINGS ARE:  
 1 Continuous slot 3 Mill slot 5 Gauzed wrapped 8 Saw cut 11 None (open hole)  
 2 Louvered shutter 4 Key punched 6 Wire wrapped 9 Drilled holes  
 7 Torch cut 10 Other (specify) -  
 SCREEN-PERFORATED INTERVALS: From 12 ft. to 22 ft., From - ft. to - ft.  
 From - ft. to - ft., From - ft. to - ft.  
 GRAVEL PACK INTERVALS: From 11 ft. to 24 ft., From - ft. to - ft.  
 From - ft. to - ft., From - ft. to - ft.

6 GROUT MATERIAL:  
 1 Neat cement 2 Cement grout 3 Bentonite 4 Other -  
 Grout Intervals: From 0 ft. to 11 ft., From - ft. to - ft., From - ft. to - ft.  
 What is the nearest source of possible contamination:  
 1 Septic tank 4 Lateral lines 7 Pit privy 10 Livestock pens 14 Abandoned water well  
 2 Sewer lines 5 Cess pool 8 Sewage lagoon 11 Fuel storage 15 Oil well/Gas well  
 3 Watertight sewer lines 6 Seepage pit 9 Feedyard 12 Fertilizer storage 16 Other (specify below) farm held run off  
 13 Insecticide storage 19 Other (specify below) -  
 Direction from well? How many feet?

FROM	TO	LITHOLOGIC LOG	FROM	TO	PLUGGING INTERVALS
0	2	soil			
2	11	silt w/ fine LS sand			
11	20	LS gravel wht to tan			
20	24	shale			
24	TD	end of Borehole			

7 CONTRACTOR'S OR LANDOWNER'S CERTIFICATION: This water well was (1) constructed, (2) reconstructed, or (3) plugged under my jurisdiction and was completed on (mo/day/year) 4-22-98 and this record is true to the best of my knowledge and belief. Kansas Water Well Contractor's License No. 585 This Water Well Record was completed on (mo/day/yr) 5/11/98 under the business name of AEI by (signature) Adrian Sir B Johnson