


MW-11

1 LOCATION OF WATER WELL: County: Kooks Fraction: NE 1/4 SE 1/4 NE 1/4 Section Number: 30 Township Number: T 8 S Range Number: R 17 E (W)

Distance and direction from nearest town or city street address of well if located within city?
from int. 183 + 18 - 6 miles N, 2.5 mile E, .7 N, 50' to west off of rd

2 WATER WELL OWNER: KCC - Bruce Basyle
 RR#, St. Address, Box #: 2301 E 13th Street Board of Agriculture, Division of Water Resources
 City, State, ZIP Code: Hayward, KS 67601 Application Number:

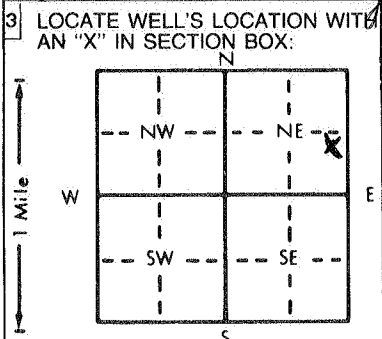

4 DEPTH OF COMPLETED WELL: 23 ft. ELEVATION: -
 Depth(s) Groundwater Encountered 1. 5 ft. 2. - ft. 3. - ft.
 WELL'S STATIC WATER LEVEL 4.72 ft. below land surface measured on mo/day/yr 5/14/98
 Pump test data: Well water was - ft. after - hours pumping - gpm
 Est. Yield - gpm: Well water was - ft. after - hours pumping - gpm
 Bore Hole Diameter: 6 in. to 23 ft., and - in. to - ft.
 WELL WATER TO BE USED AS:
 5 Public water supply 8 Air conditioning 11 Injection well
 1 Domestic 3 Feedlot 6 Oil field water supply 9 Dewatering 12 Other (Specify below)
 2 Irrigation 4 Industrial 7 Lawn and garden only 10 Monitoring well MW-11
 Was a chemical/bacteriological sample submitted to Department? Yes - No X; If yes, mo/day/yr sample was submitted
 Water Well Disinfected? Yes - No X

5 TYPE OF BLANK CASING USED:
 1 Steel 3 RMP (SR) 5 Wrought iron 8 Concrete tile CASING JOINTS: Glued - Clamped -
2 PVC 4 ABS 6 Asbestos-Cement 9 Other (specify below) Welded -
 7 Fiberglass Threaded X
 Blank casing diameter 2 in. to 12 ft., Dia. - in. to - ft., Dia. - in. to - ft.
 Casing height above land surface 71.5 in., weight SC40 lbs./ft. Wall thickness or gauge No. -
 TYPE OF SCREEN OR PERFORATION MATERIAL:
 1 Steel 3 Stainless steel 5 Fiberglass 8 RMP (SR) 10 Asbestos-cement
 2 Brass 4 Galvanized steel 6 Concrete tile 9 ABS 11 Other (specify) -
 12 None used (open hole)
 SCREEN OR PERFORATION OPENINGS ARE:
 1 Continuous slot 3 Mill slot 5 Gauzed wrapped 8 Saw cut 11 None (open hole)
 2 Louvered shutter 4 Key punched 6 Wire wrapped 9 Drilled holes
 7 Torch cut 10 Other (specify) -
 SCREEN-PERFORATED INTERVALS: From 12 ft. to 22 ft., From - ft. to - ft.
 From - ft. to - ft., From - ft. to - ft.
 GRAVEL PACK INTERVALS: From 11 ft. to 23 ft., From - ft. to - ft.
 From - ft. to - ft., From - ft. to - ft.

6 GROUT MATERIAL: 1 Neat cement 2 Cement grout 3 Bentonite 4 Other -
 Grout Intervals: From 0 ft. to 1 ft., From 1 ft. to 11 ft., From - ft. to - ft.
 What is the nearest source of possible contamination:
 1 Septic tank 4 Lateral lines 7 Pit privy 10 Livestock pens 14 Abandoned water well
 2 Sewer lines 5 Cess pool 8 Sewage lagoon 11 Fuel storage 15 Oil well/Gas well
 3 Watertight sewer lines 6 Seepage pit 9 Feedyard 12 Fertilizer storage 16 Other (specify below) farm field runoff
 13 Insecticide storage
 Direction from well? How many feet?

FROM	TO	LITHOLOGIC LOG	FROM	TO	PLUGGING INTERVALS
0	2	soil			
2	17	Silty clay (cl) brown trace LS sand			
17	20	limestone gravel			
20	23	shale dk grey blk firm.			
23	TD	end of bore hole			

7 CONTRACTOR'S OR LANDOWNER'S CERTIFICATION: This water well was (1) constructed, (2) reconstructed, or (3) plugged under my jurisdiction and was completed on (mo/day/year) 4-22-98 and this record is true to the best of my knowledge and belief. Kansas Water Well Contractor's License No. 585 This Water Well Record was completed on (mo/day/yr) 5/11/98 under the business name of ACI by (signature) Adrian B. B. B.