


1 LOCATION OF WATER WELL: County: Rooks; Fraction: NE 1/4 NW 1/4 SW 1/4; Section Number: 35; Township Number: T 8 S; Range Number: R 18 E/W

Distance and direction from nearest town or city street address of well if located within city? 1400' ENE of landfill maintenance building MW 3

2 WATER WELL OWNER: Rooks County; RR#, St. Address, Box #: 115 W Walnut; City, State, ZIP Code: Stockton, Ks. 67669; Board of Agriculture, Division of Water Resources; Application Number:

3 LOCATE WELL'S LOCATION WITH AN "X" IN SECTION BOX:

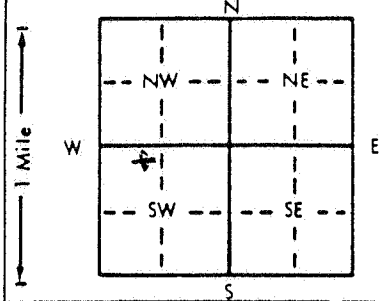

4 DEPTH OF COMPLETED WELL: 24 ft. ELEVATION: Approx. 2010; Depth(s) Groundwater Encountered 1. 9.2 ft. 2. ft. 3. ft.; WELL'S STATIC WATER LEVEL 9.2 ft. below land surface measured on mo/day/yr 6-5-93; Pump test data: Well water was ft. after hours pumping; Est. Yield NA gpm; Bore Hole Diameter .75/8 in. to .24 in.; WELL WATER TO BE USED AS: 5 Public water supply, 8 Air conditioning, 11 Injection well, 1 Domestic, 3 Feedlot, 6 Oil field water supply, 9 Dewatering, 12 Other (Specify below), 2 Irrigation, 4 Industrial, 7 Lawn and garden only, 10 Monitoring well; Was a chemical/bacteriological sample submitted to Department? Yes No X; If yes, mo/day/yr sample was submitted Water Well Disinfected? Yes No

5 TYPE OF BLANK CASING USED: 1 Steel, 2 PVC, 3 RMP (SR), 4 ABS, 5 Wrought iron, 6 Asbestos-Cement, 7 Fiberglass, 8 Concrete tile, 9 Other (specify below); CASING JOINTS: Glued, Clamped, Welded, Threaded X

Blank casing diameter .2 in. to 8.5 ft., Dia in. to ft., Dia in. to; Casing height above land surface .28 in., weight lbs./ft. Wall thickness or gauge No. Sch. 40

TYPE OF SCREEN OR PERFORATION MATERIAL: 1 Steel, 2 Brass, 3 Stainless steel, 4 Galvanized steel, 5 Fiberglass, 6 Concrete tile, 7 PVC, 8 RMP (SR), 9 ABS, 10 Asbestos-cement, 11 Other (specify), 12 None used (open hole)

SCREEN OR PERFORATION OPENINGS ARE: 1 Continuous slot, 2 Louvered shutter, 3 Mill slot, 4 Key punched, 5 Gauzed wrapped, 6 Wire wrapped, 7 Torch cut, 8 Saw cut, 9 Drilled holes, 10 Other (specify), 11 None (open hole)

SCREEN-PERFORATED INTERVALS: From 8.5 ft. to 24 ft.; GRAVEL PACK INTERVALS: From 7 ft. to 24 ft.

6 GROUT MATERIAL: 1 Neat cement, 2 Cement grout, 3 Bentonite, 4 Other; Grout Intervals: From 0 ft. to 5 ft., From 5 ft. to 7 ft.; What is the nearest source of possible contamination: 1 Septic tank, 2 Sewer lines, 3 Watertight sewer lines, 4 Lateral lines, 5 Cess pool, 6 Seepage pit, 7 Pit privy, 8 Sewage lagoon, 9 Feedyard, 10 Livestock pens, 11 Fuel storage, 12 Fertilizer storage, 13 Insecticide storage, 14 Abandoned water well, 15 Oil well/Gas well, 16 Other (specify below) landfill; Direction from well? west; How many feet? 50

Table with columns: FROM, TO, LITHOLOGIC LOG, FROM, TO, PLUGGING INTERVALS. Row 1: 0, 20, Clay, tan to brown, slightly silty; Row 2: 20, 24, Shale, light gray

7 CONTRACTOR'S OR LANDOWNER'S CERTIFICATION: This water well was (1) constructed, (2) reconstructed, or (3) plugged under my jurisdiction and completed on (mo/day/year) 4-29-93 and this record is true to the best of my knowledge and belief. Kan Water Well Contractor's License No. 527 This Water Well Record was completed on (mo/day/yr) 6-29-93 under the business name of GeoCore Services, Inc. by (signature) Dal [unintelligible]

INSTRUCTIONS: Use typewriter or ball point pen. PLEASE PRESS FIRMLY and PRINT clearly. Please fill in blanks, underline or circle the correct answers. Send top three copies to Kansas Department of Health and Environment, Bureau of Water, Topeka, Kansas 66620-0001. Telephone: 913-296-5545. Send one to WATER WELL OWNER and retain one for your records.