To BWS 9-12-78

USE TYPEWRITER OR BALL POINT PEN-PRESS FIRMLY, PRINT CLEARLY.

WATER WELL RECORD
KSA 82a-1201-1215

Kansas Department of Health and Environment-Division of Environment
(Water well Contractors)
Topeka, Kansas 66620

| 1. Location of well: | County | Fraction | Section number | Township number | Range number |
|---|---|---|---|---|---|
| | Rooks | SE 1/4 SE 1/4 NE 1/4 | 3 | T 8 S | R 19 ~~E~~/W |

2. Distance and direction from nearest town or city: 9 Mi. West of Stockton, Ks. + 3 Mi. S. ~~& 1 Mi. W.~~
Street address of well location if in city:

3. Owner of well: Webster State Park
R.R. or street: Stockton, Kansas
City, state, zip code: Don Jenkins, Mgr.

4. Locate with "X" in section below:

Sketch map:

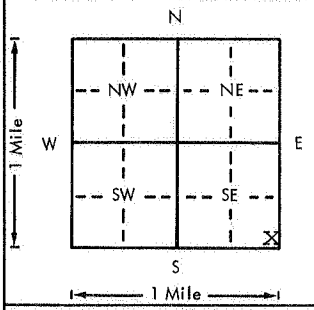


6. Bore hole dia. 18 in. Completion date 11-10-76
Well depth 80'6"

7. __ Cable tool __ Rotary __ Driven __ Dug
__ Hollow rod __ Jetted __ Bored XX Reverse rotary

8. Use: __ Domestic X Public supply __ Industry
__ Irrigation __ Air conditioning __ Stock
__ Lawn __ Oil field water __ Other

9. Casing: Material _____ Height: Above ~~or below~~
Threaded ____ Welded ____ Surface 3'0" in.
RMP ____ PVC X Weight 5.32 lbs./ft.
Dia. 6 in. to 57 ft. depth Wall Thickness: inches or
Dia. 6 in. to ____ ft. depth gage No. 0.432"

| 5. Type and color of material | From | To |
|---|---|---|
| Soil | 0 | 2 |
| Fine silty sand | 2 | 14 |
| Fine to coarse sand | 14 | 31 |
| Gray clay w/fine sand | 31 | 57 |
| Med. to coarse sand w/white rock | 57 | 77 |
| Blue shale | 77 | 80 |

(Use a second sheet if needed)

10. Screen: Manufacturer's name Layne
Type Sch 80 PVC Dia. 6"
Slot/gauze .100" Length 20'
Set between ____ ft. and ____ ft.
60 ft. and 80 ft.
Gravel pack? yes Size range of material 1/8-3/8"

11. Static water level: mo./day/yr.
64 ft. below land surface Date 11-9-76

12. Pumping level below land surfaces:
74 ft. after 4 hrs. pumping 11 g.p.m.
____ ft. after ____ hrs. pumping ____ g.p.m.
Estimated maximum yield 15 g.p.m.

13. Water sample submitted: mo./day/yr.
X Yes ____ No Date 11-10-76

14. Well head completion:
X Pitless adapter 36 Inches above grade

15. Well grouted? yes
With: ____ Neat cement ____ Bentonite X Concrete
Depth: From 0 ft. to 20 ft.

16. Nearest source of possible contamination: Vault
ft. 2400 Direction N Type Toilet
Well disinfected upon completion? X Yes ____ No

17. Pump: ____ Not installed
Manufacturer's name Jacuzzi Bros.
Model number 6E7083141 HP ____ Volts 220
Length of drop pipe 72 ft. capacity 15 g.p.m.
Type:
X Submersible ____ Turbine
____ Jet ____ Reciprocating
____ Centrifugal ____ Other

T 8 R 19 E/W Sec 3 1/4 1/4 1/4 1/4 SE SE NE

18. Elevation:
Topography:
____ Hill
____ Slope
____ Upland
X Valley

19. Remarks:
Well is located at south end of dam

20. Water well contractor's certification:
This well was drilled under my jurisdiction and this report is true to the best of my knowledge and belief.
Layne Western Co. 102
Business name License No.
Address Wichita, Kansas
Signed [signature] Date 11/12/76
Authorized Representative

Forward the white, blue and pink copies to the Department of Health and Environment

Form WWC-5

MI-1023