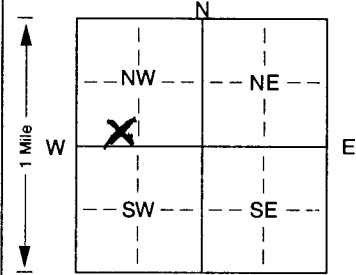


1 LOCATION OF WATER WELL: Fraction SE 1/4 SW 1/4 NW 1/4 Section Number 18 Township Number T B S Range Number R 2 EW

County: CLOUD
 Distance and direction from nearest town or city street address of well if located within city?
FROM MELTOWNVILLE: 7 WEST AND 3/4 NORTH OR A 1/4 MILE SOUTH OF HWY 24

2 WATER WELL OWNER: REICHARD WEAVER
 RR#, St. Address, Box # : N. 160 RD & EAGLE Board of Agriculture, Division of Water Resources
 City, State, ZIP Code : AURORA, KS 67417 Application Number: _____

3 LOCATE WELL'S LOCATION WITH AN "X" IN SECTION BOX:  4 DEPTH OF COMPLETED WELL: 200 ft. ELEVATION: _____
 Depth(s) Groundwater Encountered 1. 149 ft. 2. _____ ft. 3. _____ ft.
 WELL'S STATIC WATER LEVEL: 98 ft. below land surface measured on mo/day/yr 11/25/03
 Pump test data: Well water was _____ ft. after _____ hours pumping _____ gpm
 Est. Yield 2-3 gpm: Well water was _____ ft. after _____ hours pumping _____ gpm
 Bore Hole Diameter: 9 in. to 200 ft., and _____ in. to _____ ft.
 WELL WATER TO BE USED AS: 5 Public water supply 8 Air conditioning 11 Injection well
 Domestic 3 Feedlot 6 Oil field water supply 9 Dewatering 12 Other (Specify below)
 2 Irrigation 4 Industrial 7 Domestic (lawn & garden) 10 Monitoring well _____
 Was a chemical/bacteriological sample submitted to Department? Yes. _____ No. ; If yes, mo/day/yr sample was submitted
 Water Well Disinfected? Yes No _____

5 TYPE OF BLANK CASING USED: 5 Wrought iron 8 Concrete tile CASING JOINTS: Glued Clamped _____
 1 Steel 3 RMP (SR) Welded _____
 PVC 4 ABS 7 Fiberglass Threaded _____
 Blank casing diameter 5 in. to 140 ft., Dia 5" in. to 190 ft., Dia _____ in. to _____ ft.
 Casing height above land surface: 24 in., weight _____ lbs./ft. Wall thickness or gauge No. 5DR26
 TYPE OF SCREEN OR PERFORATION MATERIAL: PVC 10 Asbestos-cement
 1 Steel 3 Stainless steel 5 Fiberglass 8 RMP (SR) 11 Other (specify) _____
 2 Brass 4 Galvanized steel 6 Concrete tile 9 ABS 12 None used (open hole)
 SCREEN OR PERFORATION OPENINGS ARE: 5 Gauzed wrapped 8 Saw cut 11 None (open hole)
 1 Continuous slot 2 MIL slot 6 Wire wrapped 9 Drilled holes
 2 Louvered shutter 4 Key punched 7 Torch cut 10 Other (specify) _____ ft.
 SCREEN-PERFORATED INTERVALS: From 140 ft. to 150 ft., From _____ ft. to _____ ft.
 From 190 ft. to 200 ft., From _____ ft. to _____ ft.
 GRAVEL PACK INTERVALS: From 25 ft. to 200 ft., From _____ ft. to _____ ft.
 From _____ ft. to _____ ft., From _____ ft. to _____ ft.

6 GROUT MATERIAL: 1 Neat cement 2 Cement grout Bentonite 4 Other _____
 Grout Intervals: From 3 ft. to 25 ft., From _____ ft. to _____ ft., From _____ ft. to _____ ft.
 What is the nearest source of possible contamination:
 1 Septic tank 4 Lateral lines 7 Pit privy 10 Livestock pens 14 Abandoned water well
 2 Sewer lines 5 Cess pool 8 Sewage lagoon 11 Fuel storage 15 Oil well/Gas well
 3 Watertight sewer lines 6 Seepage pit 9 Feedyard 12 Fertilizer storage 16 Other (specify below)
WELL PIT
 Direction from well? SOUTH How many feet? ~30

FROM	TO	LITHOLOGIC LOG	FROM	TO	PLUGGING INTERVALS
0	25	CLAY			
25	75	SHALE, RED TAN, GRAY			
75	77	SANDSTONE			
77	148	SHALE, RED			
148	149	SANDSTONE			
149	200	SHALE, RED TO GRAY			
	200	TOTAL DEPTH			

7 CONTRACTOR'S OR LANDOWNER'S CERTIFICATION: This water well was constructed, reconstructed, or plugged under my jurisdiction and was completed on (mo/day/year) 12/10/03 11/25/03 and this record is true to the best of my knowledge and belief. Kansas Water Well Contractor's Licence No. 585 This Water Well Record was completed on (mo/day/yr) 12/10/03 under the business name of ASSOCIATED ENVIRONMENTAL INC. by (signature) [Signature]