


1 LOCATION OF WATER WELL: County: Prichard Fraction: SE 1/4 SW 1/4 SW 1/4 Section Number: 7 Township Number: T 8 S Range Number: R 22 EW

Distance and direction from nearest town or city street address of well if located within city?  
one mile east of Stop Light of Hill City Kansas on Highway 24 and 300 feet east & 100 feet north

2 WATER WELL OWNER: Eugene Johnson Board of Agriculture, Division of Water Resources  
 RR#, St. Address, Box #: RR 2 Box 249 City, State, ZIP Code: Hill City Kansas 67642 Application Number:

3 LOCATE WELL'S LOCATION WITH AN "X" IN SECTION BOX:

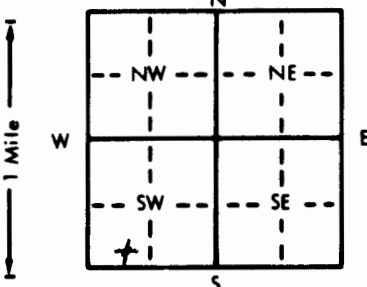

4 DEPTH OF COMPLETED WELL: 90 ft. ELEVATION:

Depth(s) Groundwater Encountered 1. 50 ft. 2. ft. 3. ft.  
 WELL'S STATIC WATER LEVEL 50 ft. below land surface measured on mo/day/yr 10-10-86  
 Pump test data: Well water was ft. after hours pumping gpm  
 Est. Yield 30 gpm; Well water was ft. after hours pumping gpm  
 Bore Hole Diameter 10 1/2 in. to ft., and in. to ft.  
 WELL WATER TO BE USED AS:  
 Domestic 3 Feedlot 6 Oil field water supply 9 Dewatering 12 Other (Specify below)  
 2 Irrigation 4 Industrial  Lawn and garden only 10 Observation well  
 Was a chemical/bacteriological sample submitted to Department? Yes.....No.....; If yes, mo/day/yr sample was submitted  
 Water Well Disinfected? Yes  No

5 TYPE OF BLANK CASING USED:  
 1 Steel 3 RMP (SR) 5 Wrought iron 8 Concrete tile CASING JOINTS:  Glued  Clamped  
 2 PVC 4 ABS 6 Asbestos-Cement 9 Other (specify below)  Welded  
 7 Fiberglass  Threaded

Blank casing diameter 5 1/2 in. to 90 ft., Dia. in. to ft., Dia. in. to ft.  
 Casing height above land surface 18 in., weight 160 lbs./ft. Wall thickness or gauge No. 4

TYPE OF SCREEN OR PERFORATION MATERIAL:  
 1 Steel 3 Stainless steel 5 Fiberglass 8 RMP (SR) 10 Asbestos-cement  
 2 Brass 4 Galvanized steel 6 Concrete tile 9 ABS 11 Other (specify)  
 7 PVC

SCREEN OR PERFORATION OPENINGS ARE:  
 1 Continuous slot 3 Mill slot 5 Gauzed wrapped 8 Saw cut 11 None (open hole)  
 2 Louvered shutter 4 Key punched 6 Wire wrapped 9 Drilled holes  
 7 Torch cut 10 Other (specify)

SCREEN-PERFORATED INTERVALS: From 90 ft. to 50 ft., From ft. to ft.  
 GRAVEL PACK INTERVALS: From 90 ft. to 20 ft., From ft. to ft.

6 GROUT MATERIAL: 1 Neat cement 2 Cement grout 3 Bentonite 4 Other  
 Grout intervals: From 20 ft. to 0 ft., From ft. to ft., From ft. to ft.

What is the nearest source of possible contamination:  
 1 Septic tank 4 Lateral lines 7 Pit privy 10 Livestock pens 14 Abandoned water well  
 2 Sewer lines 5 Cess pool 8 Sewage lagoon 11 Fuel storage 15 Oil well/Gas well  
 3 Watertight sewer lines 6 Seepage pit 9 Feedyard 12 Fertilizer storage 16 Other (specify below)  
 13 Insecticide storage  
 Direction from well? West How many feet? 7500 ft

FROM	TO	LITHOLOGIC LOG	FROM	TO	LITHOLOGIC LOG
0	22	Hard surface clay			
22	36	Yellow clay			
36	53	Light sand & clays			
53	66	Water bearing sand & small			
66	80	fine sand & clay			
80	90	Reg. gravel to large sand			

7 CONTRACTOR'S OR LANDOWNER'S CERTIFICATION: This water well was (1) constructed, (2) reconstructed, or (3) plugged under my jurisdiction and was completed on (mo/day/year) 10-10-86 and this record is true to the best of my knowledge and belief. Kansas Water Well Contractor's License No. 444 This Water Well Record was completed on (mo/day/yr) under the business name of Andrus Drilling by (signature) Andy Andrus

INSTRUCTIONS: Use typewriter or ball point pen. PLEASE PRESS FIRMLY and PRINT clearly. Please fill in blanks, underline or circle the correct answers. Send top three copies to Kansas Department of Health and Environment, Office of Oil Field and Environmental Geology, Regulation and Permitting Section, Topeka, Kansas 66620-7500, Telephone: 783-862-9360. Send one to WATER WELL OWNER and retain one for your records.