

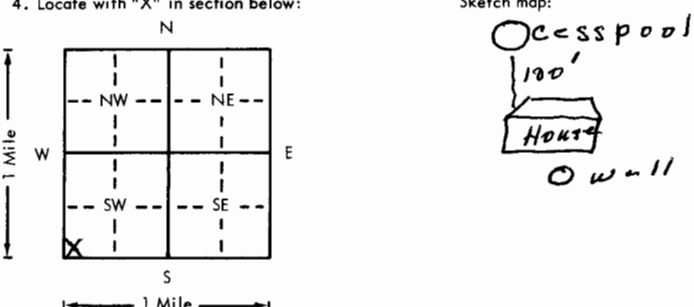
USE TYPEWRITER OR BALL POINT PEN-PRESS FIRMLY, PRINT CLEARLY.

HILL CITY 5

WATER WELL RECORD
KSA 82a-1201-1215

Kansas Department of Health and Environment-Division of Environment (Water well Contractors) Topeka, Kansas 66620

CCC

1. Location of well:		County GRAHAM	Fraction SW 1/4 SW 1/4 SW 1/4	Section number 7	Township number T 8 S	Range number R 22 EW	
2. Distance and direction from nearest town or city: 1 mile EAST ON Highway 24 E. Street address of well location if in city: Hill City, KS			3. Owner of well: KENT NOAH R.R. or street: Highway 24 E City, state, zip code: Hill City, KS. 67642				
4. Locate with "X" in section below:		Sketch map: 		6. Bore hole dia. 9 in. Completion date 4/18/78 Well depth 83 ft.			
5. Type and color of material		From	To	7. <input checked="" type="checkbox"/> Cable tool <input checked="" type="checkbox"/> Rotary <input type="checkbox"/> Driven <input type="checkbox"/> Dug <input type="checkbox"/> Hollow rod <input type="checkbox"/> Jetted <input type="checkbox"/> Bored <input type="checkbox"/> Reverse rotary			
				8. Use: <input checked="" type="checkbox"/> Domestic <input type="checkbox"/> Public supply <input type="checkbox"/> Industry <input type="checkbox"/> Irrigation <input type="checkbox"/> Air conditioning <input type="checkbox"/> Stock <input type="checkbox"/> Lawn <input type="checkbox"/> Oil field water <input type="checkbox"/> Other			
				9. Casing: Material PLST Height: Above or below Threaded <input type="checkbox"/> Welded <input checked="" type="checkbox"/> Surface 18 in. RMP <input type="checkbox"/> PVC <input checked="" type="checkbox"/> Weight _____ lbs./ft. Dia. 5 in. to 83 ft. depth Wall Thickness: inches or Dia. _____ in. to _____ ft. depth gage No. 220			
				10. Screen: Manufacturer's name _____ Type PLASTIC Dia. 5" Slot/gauze 46 Length 10' Set between 73 ft. and 83 ft. ft. and _____ ft. Gravel pack? YES Size range of material 1/4 - 3/8"			
				11. Static water level: _____ mo./day/yr. 57 ft. below land surface Date 4/18/78			
				12. Pumping level below land surfaces: NOT PUMPED _____ ft. after _____ hrs. pumping _____ g.p.m. _____ ft. after _____ hrs. pumping _____ g.p.m. Estimated maximum yield _____ g.p.m.			
				13. Water sample submitted: _____ mo./day/yr. Yes <input checked="" type="checkbox"/> No <input type="checkbox"/> Date _____			
				14. Well head completion: NOT DONE _____ Pitless adapter _____ Inches above grade			
				15. Well grouted? YES With: <input checked="" type="checkbox"/> Neat cement <input type="checkbox"/> Bentonite <input type="checkbox"/> Concrete Depth: From 4 ft. to 15 ft.			
				16. Nearest source of possible contamination: CESS ft. 100 Direction NORTH Type POOL Well disinfected upon completion? <input checked="" type="checkbox"/> Yes <input type="checkbox"/> No			
				17. Pump: <input checked="" type="checkbox"/> Not installed Manufacturer's name _____ Model number _____ HP _____ Volts _____ Length of drop pipe _____ ft. capacity _____ g.p.m. Type: <input type="checkbox"/> Submersible <input type="checkbox"/> Turbine <input type="checkbox"/> Jet <input type="checkbox"/> Reciprocating <input type="checkbox"/> Centrifugal <input type="checkbox"/> Other			
18. Elevation:		19. Remarks:		20. Water well contractor's certification:			
Topography: <input checked="" type="checkbox"/> Hill <input type="checkbox"/> Slope <input type="checkbox"/> Upland <input type="checkbox"/> Valley		CUSTOMER TO RUN CONCRETE SLAB AT GROUND SURFACE.		This well was drilled under my jurisdiction and this report is true to the best of my knowledge and belief. D & L DRILLING CO 303 Business name 304 368 License No. Address HILL CITY, KS. 67642 Signed Alkan [Signature] Date _____ Authorized representative			

(Use a second sheet if needed)

S-220-7 SUS 5500

Forward the white, blue and pink copies to the Department of Health and Environment

Form WWC-5