


1 LOCATION OF WATER WELL: County: <b>Graham</b>	Fraction <b>NE ¼ NE ¼ NE ¼</b>	Section Number <b>14</b>	Township Number <b>T 8 S</b>	Range Number <b>R 23 E</b>
----------------------------------------------------	-----------------------------------	-----------------------------	---------------------------------	-------------------------------

Distance and direction from nearest town or city street address of well if located within city?

**406 W. Main - Hill City, KS**

2 WATER WELL OWNER: **Consolidated State Bank**  
 RR#, St. Address, Box # : **P.O. Box 369** Board of Agriculture, Division of Water Resources  
 City, State, ZIP Code : **Hill City, Kansas 67642** Application Number:

3 LOCATE WELL'S LOCATION WITH AN "X" IN SECTION BOX:

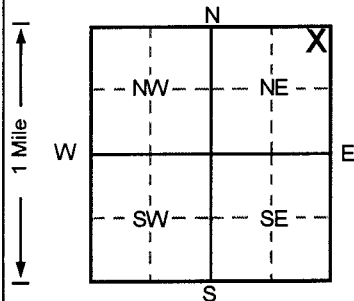

4 DEPTH OF COMPLETED WELL: **50** ft. ELEVATION: **2194.01**  
 Depth(s) Groundwater Encountered 1. **42** ft. 2. ft. 3. ft.  
 WELL'S STATIC WATER LEVEL: **36.83** ft. below land surface measured on mo/day/yr **1/30/96**  
 Pump test data: Well water was **NA** ft. after hours pumping gpm  
 Est. Yield **NA** gpm: Well water was ft. after hours pumping gpm  
 Bore Hole Diameter **8** in. to **50** ft., and in. to ft.  
 WELL WATER TO BE USED AS: 5 Public water supply 8 Air conditioning 11 Injection well  
 1 Domestic 3 Feedlot 6 Oil field water supply 9 Dewatering 12 Other (Specify below)  
 2 Irrigation 4 Industrial 7 Lawn and garden only **10** Monitoring well  
 Was a chemical/bacteriological sample submitted to Department? Yes.....No .....; If yes, mo/day/yr sample was submitted  
 Water Well Disinfected? Yes No

5 TYPE OF BLANK CASING USED:  
 1 Steel 3 RMP (SR) 5 Wrought iron 8 Concrete tile CASING JOINTS: Glued Clamped  
**2** PVC 4 ABS 6 Asbestos-Cement 9 Other (specify below) Welded  
 7 Fiberglass Threaded

Blank casing diameter **2** in. to **30** ft., Dia in. to ft., Dia in. to ft.  
 Casing height above land surface **-6** in., weight lbs./ft. Wall thickness or gauge No. **Sch. 40**

TYPE OF SCREEN OR PERFORATION MATERIAL  
 1 Steel 3 Stainless steel 5 Fiberglass **7** PVC 10 Asbestos-cement  
 2 Brass 4 Galvanized steel 6 Concrete tile 8 RMP (SR) 11 Other (specify)  
 12 None used (open hole)

SCREEN OR PERFORATION OPENINGS ARE:  
 1 Continuous slot **3** Mill slot 5 Gauzed wrapped 8 Saw cut 11 None (open hole)  
 2 Louvered shutter 4 Key punched 6 Wire wrapped 9 Drilled holes  
 7 Torch cut 10 Other (specify)

SCREEN-PERFORATED INTERVALS: From **30** ft. to **50** ft., From ft. to ft.  
 From ft. to ft., From ft. to ft.  
 GRAVEL PACK INTERVALS: From **28** ft. to **50** ft., From ft. to ft.  
 From ft. to ft., From ft. to ft.

6 GROUT MATERIAL: 1 Neat cement **2** Cement grout **3** Bentonite 4 Other  
 Grout Intervals: From **0** ft. to **26** ft., From **26** ft. to **28** ft., From ft. to ft.

What is the nearest source of possible contamination:  
 1 Septic tank 4 Lateral lines 7 Pit privy 10 Livestock pens 14 Abandoned water well  
 2 Sewer lines 5 Cess pool 8 Sewage lagoon 11 Fuel storage 15 Oil well/Gas well  
 3 Watertight sewer lines 6 Seepage pit 9 Feedyard 12 Fertilizer storage **16** Other (specify below)  
**Former UST Basins**  
 Direction from well? **NE** How many feet? **406**

FROM	TO	LITHOLOGIC LOG	FROM	TO	PLUGGING INTERVALS
0	3	Clay, Dark Brown			
3	12	Clay, Brown			
12	16	Clay, Red Brown			
16	22	Clay, Red Brown			
22	27	Clay, Light Brown			
27	39	Clay, Light Brown			
39	42	Clay, Very Light Brown			
42	50	Sand, Gray			
					MW3 , Tag # 00160018 , Flushmount
					Project Name: Hill City APCO
					GeoCore # 200 , KDHE # U6 033 765

7 CONTRACTOR'S OR LANDOWNER'S CERTIFICATION: This water well was **1** constructed, (2) reconstructed, or (3) plugged under my jurisdiction and was completed on (mo/day/year) **2/16/96** and this record is true to the best of my knowledge and belief.  
 Kansas Water Well Contractor's License No. **527** This Water Well Record was completed on (mo/day/yr) **3/4/96**  
 under the business name of **GeoCore Services, Inc.** by (signature) *Dale Rofel*