


1 LOCATION OF WATER WELL: County: Graham Fraction: NW 1/4 NW 1/4 NW 1/4 Section Number: 14 Township Number: T 8 S Range Number: R 23 E/W

Distance and direction from nearest town or city street address of well if located within city?

406 W. Main - Hill City, KS

2 WATER WELL OWNER: Consolidated State Bank RR#: St. Address, Box #: P.O. Box 369 City, State, ZIP Code: Hill City, Kansas 67642 Board of Agriculture, Division of Water Resources Application Number:

3 LOCATE WELL'S LOCATION WITH AN 'X' IN SECTION BOX:

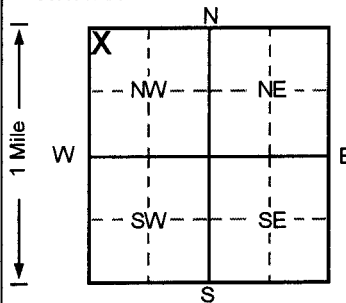

4 DEPTH OF COMPLETED WELL: 50 ft. ELEVATION: 2189.17. WELL'S STATIC WATER LEVEL: 31.11 ft. below land surface measured on 1/30/96. Pump test data: Well water was NA ft. after NA hours pumping. Est. Yield: NA gpm.

5 TYPE OF BLANK CASING USED: 2 PVC. 5 Wrought iron. 8 Concrete tile. CASING JOINTS: Glued, Clamped, Welded, Threaded. Blank casing diameter: 2 in. to 30 ft., Dia. Casing height above land surface: -4.2 in., weight. TYPE OF SCREEN OR PERFORATION MATERIAL: 7 PVC. 10 Asbestos-cement.

6 GROUT MATERIAL: 2 Cement grout, 3 Bentonite. Grout Intervals: From 0 ft. to 26 ft., From 26 ft. to 28 ft. What is the nearest source of possible contamination: 16 Other (specify below) Former: UST Basins.. Direction from well? NE. How many feet? 616

LITHOLOGIC LOG table with columns FROM, TO, LITHOLOGIC LOG, FROM, TO, PLUGGING INTERVALS. Rows show geological layers like Clay, Dark Brown and Shale, Dark Gray.

7 CONTRACTOR'S OR LANDOWNER'S CERTIFICATION: This water well was (1) constructed, (2) reconstructed, or (3) plugged under my jurisdiction and was completed on (mo/day/year) 2/16/96. Kansas Water Well Contractor's License No. 527. This Water Well Record was completed on (mo/day/yr) 3/4/96 under the business name of GeoCore Services, Inc. by (signature) Dale Kobi