


1 LOCATION OF WATER WELL: County: <b>Graham</b>		Fraction <b>SE ¼ NE ¼ NE ¼</b>	Section Number <b>14</b>	Township Number <b>T 8 S</b>	Range Number <b>R 23 E/W</b>
--	--	-----------------------------------	-----------------------------	---------------------------------	---------------------------------

Distance and direction from nearest town or city street address of well if located within city?  
**406 W. Main - Hill City, KS**

2 WATER WELL OWNER: **Consolidated State Bank**  
 RR#, St. Address, Box # : **P.O. Box 369**  
 City, State, ZIP Code : **Hill City, Kansas 67642**  
 Board of Agriculture, Division of Water Resources  
 Application Number:

3 LOCATE WELL'S LOCATION WITH AN "X" IN SECTION BOX:

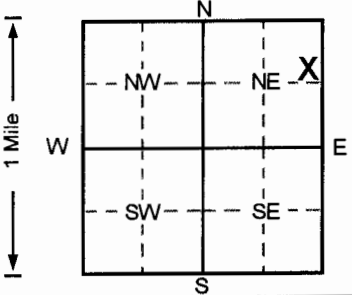

4 DEPTH OF COMPLETED WELL ..... **50** ..... ft. ELEVATION: ..... **2181.83** .....  
 Depth(s) Groundwater Encountered 1..... ft. 2..... ft. 3..... ft.  
 WELL'S STATIC WATER LEVEL ... **32.52** ... ft. below land surface measured on **mo/day/yr** ..... **1/30/96** .....  
 Pump test data: Well water was ... **NA** ... ft. after ..... hours pumping ..... gpm  
 Est. Yield ... **NA** ... gpm: Well water was ..... ft. after ..... hours pumping ..... gpm  
 Bore Hole Diameter ... **8** ... in. to ... **50** ... ft., and ... in. to ... ft.  
 WELL WATER TO BE USED AS: 5 Public water supply 8 Air conditioning 11 Injection well  
 1 Domestic 3 Feedlot 6 Oil field water supply 9 Dewatering 12 Other (Specify below)  
 2 Irrigation 4 Industrial 7 Lawn and garden only **10 Monitoring well**  
 Was a chemical/bacteriological sample submitted to Department? Yes.....No✓.....; If yes, mo/day/yr sample was submitted  
 Water Well Disinfected? Yes No ✓

5 TYPE OF BLANK CASING USED:  
 1 Steel 3 RMP (SR) 5 Wrought iron 8 Concrete tile  
**2 PVC** 4 ABS 6 Asbestos-Cement 9 Other (specify below)  
 7 Fiberglass  
 CASING JOINTS: Glued..... Clamped.....  
 Welded.....  
 Threaded. ✓

Blank casing diameter ..... **2** ..... in. to ..... **30** ..... ft., Dia ..... in. to ..... ft., Dia ..... in. to ..... ft.  
 Casing height above land surface ..... **4.32** ..... in., weight ..... lbs./ft. Wall thickness or gauge No. ..... **Sch. 40** .....

TYPE OF SCREEN OR PERFORATION MATERIAL  
 1 Steel 3 Stainless steel 5 Fiberglass **7 PVC** 10 Asbestos-cement  
 2 Brass 4 Galvanized steel 6 Concrete tile 8 RMP (SR) 11 Other (specify).....  
 12 None used (open hole)

SCREEN OR PERFORATION OPENINGS ARE:  
 1 Continuous slot **3 Mill slot** 5 Gauzed wrapped 8 Saw cut 11 None (open hole)  
 2 Louvered shutter 4 Key punched 6 Wire wrapped 9 Drilled holes  
 7 Torch cut 10 Other (specify).....

SCREEN-PERFORATED INTERVALS: From ..... **30** ..... ft. to ..... **50** ..... ft., From ..... ft. to ..... ft.  
 From ..... ft. to ..... ft., From ..... ft. to ..... ft.  
 GRAVEL PACK INTERVALS: From ..... **28** ..... ft. to ..... **50** ..... ft., From ..... ft. to ..... ft.  
 From ..... ft. to ..... ft., From ..... ft. to ..... ft.

6 GROUT MATERIAL: 1 Neat cement **2 Cement grout** **3 Bentonite** 4 Other .....  
 Grout Intervals: From ..... **0** ..... ft. to ..... **26** ..... ft., From ..... **26** ..... ft. to ..... **28** ..... ft., From ..... ft. to ..... ft.

What is the nearest source of possible contamination:  
 1 Septic tank 4 Lateral lines 7 Pit privy 10 Livestock pens 14 Abandoned water well  
 2 Sewer lines 5 Cess pool 8 Sewage lagoon 11 Fuel storage **15 Oil well/Gas well**  
 3 Watertight sewer lines 6 Seepage pit 9 Feedyard 12 Fertilizer storage **16 Other (specify below)**  
 ..... **Former UST Basins** .....  
 13 Insecticide storage  
 Direction from well? **NE** How many feet? **994**

FROM	TO	LITHOLOGIC LOG	FROM	TO	PLUGGING INTERVALS
0	3	Clay, Brown			
3	13	Silt, Brown			
13	18	Clay, Medium Brown			
18	24	Sand, Red Brown			
24	28	Clay, Yellow Brown Tan			
28	50	Clay, Light Gray			

7 CONTRACTOR'S OR LANDOWNER'S CERTIFICATION: This water well was **(1)** constructed, (2) reconstructed, or (3) plugged under my jurisdiction and was completed on (mo/day/year) ..... **2/16/96** ..... and this record is true to the best of my knowledge and belief.  
 Kansas Water Well Contractor's License No. .... **527** ..... This Water Well Record was completed on (mo/day/yr) ..... **3/4/96** ..... under the business name of **GeoCore Services, Inc.** by (signature) *Dale Roll*

INSTRUCTIONS: Use typewriter or ball point pen. PLEASE PRESS FIRMLY and PRINT clearly. Please fill in blanks, underline or circle the correct answers. Send top three copies to Kansas Department of Health and Environment, Bureau of Water, Topeka, Kansas 66620-0001. Telephone: 913-296-5545. Send one to WATER WELL OWNER and retain one for your records.

OFFICE USE ONLY

T

R

EW

SEC.

1/4

1/4

1/4