USE TYPEWRITER OR BALL POINT PEN-PRESS FIRMLY, PRINT CLEARLY.

HILL CITY SP

T R EW sec 1/4 1/4 1/4 No.

WATER WELL RECORD
KSA 82a-1201-1215

BDB

Kansas State Dept. Of Health
(Water Well Contractors)
Forbes-Bldg. 740
Topeka, Kansas 66620

1 Location of well:	County	Township name	Fraction	Section number	Town number	Range number
	Graham	Hill City	NWSENW	13	T 8S	R 23W

Distance and direction from nearest town or city: 1/4 Mile east of Hill City, Kansas

Street address of well location if in city:

3 Owner of well: Jim Murphy

Address: Hill City, Kansas

Locate with "X" in section below:

Sketch map:

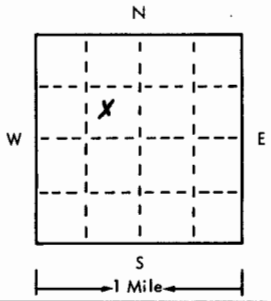

4 Well depth: 40' ft. Date of completion 3/1/75
Well diameter 10" in.

5 ☐ Cable tool ☒ Rotary ☐ Driven ☐ Dug
☐ Hollow rod ☐ Jetted ☐ Bored ☐ Reverse rotary

6 Use: ☐ Domestic ☐ Public supply ☐ Industry
☐ Irrigation ☐ Air conditioning ☒ Commercial
☐ Test well ☐ Slaughter House

7 Casing: Material PVC Height: above/below
Threaded ☐ Welded ☒ Surface 24 in.
Diam. Weight ____ lbs./ft.
5 in. to 40 ft. depth Drive shoe? ☐ Yes ☒ No
____ in. to ____ ft. depth

2

Type and color of material	From	To
Black Dirt	0	3
Sandy Clay	3	12
Fine Sand	12	25
Water Bearing Sand	25	40
?		
Not in Use		

(use a second sheet if needed)

8 Screen:
Manufacturer Western
Type PVC Dia. 5"
Slot/gauze 1/8" Length 20'
Set between 30 ft. and 40 ft.
Fittings:
Gravel pack ☒ Yes ☐ No Size range of material 1/4"

9 Static water level:
10 ft. below land surface Date 3/1/75

10 Pumping level below land surface:
20 ft. after 1 Hr hrs. pumping 30 g.p.m.
____ ft. after ____ hrs. pumping ____ g.p.m.
Estimated maximum yield ____ g.p.m.

11 Water sample submitted:
☐ Yes ☒ No Date ____

12 Well head completion: Bury Tank
☒ Pitless adapter ☐ Inches above grade

13 Well grouted? ☒ Yes ☐ No
☒ Neat cement ☐ Bentonite ☐ ____
Depth: From 6' ft. to 13' ft.

14 Nearest source of possible contamination:
ft. 200' Direction West Type Dry Creek
Well disinfected upon completion? ☒ Yes ☐ No

15 Pump: ☒ Not installed
Manufacturer's name ____
Model number ____ HP ____ Volts ____
Length of drop pipe ____ ft. capacity ____ g.m.p.
Type:
☐ Submersible ☐ Turbine
☐ Jet ☐ Reciprocating
☐ Centrifugal ☐ Other

16 Remarks: elevation 2134 (TOPO)

Topography:
☐ Hill
☐ Slope
☐ Upland
☒ Valley

17 Water well contractor's certification: 269
This well was drilled under my jurisdiction and this report is true to the best of my knowledge and belief.
Business name P & J Well Drilling License No. 260
Address Palco & Kansas
Signed [signature] Date 3/1/75
Authorized representative

8 23W 13 SE NWSE NW

Forward the white, blue and pink copies to the Kansas State Dept. Of Health.

Form WWC-5

877-H