

7-00-000

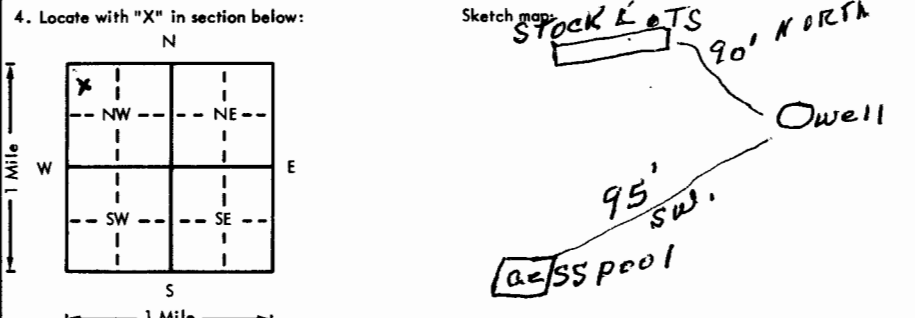
WENOCREE

BFB

USE TYPEWRITER OR BALL POINT PEN-PRESS FIRMLY, PRINT CLEARLY.

WATER WELL RECORD
KSA 82a-1201-1215

Kansas Department of Health and Environment-Division of Environment
(Water well Contractors)
Topeka, Kansas 66620

| | |
|---|--|
| 1. Location of well: County GRAHAM Fraction NW 1/4 NW 1/4 SW 1/4 Section number 15 Township number T 8 S R 23 E 1 Range number 23 | |
| 2. Distance and direction from nearest town or city: 2 WEST AND 1/8 SOUTH Street address of well location if in city: HILL CITY, KS 3. Owner of well: ROGER W. JONES R.R. or street: 517 N 9TH AVE City, state, zip code: HILL CITY, KS. 67642 | |
| 4. Locate with "X" in section below:  6. Bore hole dia. 9 in. Completion date 7/16/77 Well depth 58 ft. | |
| 7. <input checked="" type="checkbox"/> Cable tool <input checked="" type="checkbox"/> Rotary <input type="checkbox"/> Driven <input type="checkbox"/> Dug <input type="checkbox"/> Hollow rod <input type="checkbox"/> Jetted <input type="checkbox"/> Bored <input type="checkbox"/> Reverse rotary | |
| 8. Use: <input checked="" type="checkbox"/> Domestic <input type="checkbox"/> Public supply <input type="checkbox"/> Industry <input type="checkbox"/> Irrigation <input type="checkbox"/> Air conditioning <input type="checkbox"/> Stock <input type="checkbox"/> Lawn <input type="checkbox"/> Oil field water <input type="checkbox"/> Other | |
| 9. Casing: Material PIST Height: (Above) or below Threading Welded Dia. 18 in. RMP <input checked="" type="checkbox"/> PVC <input type="checkbox"/> Weight 912 lbs./ft. Dia. 5 in. to 495 ft. depth Wall Thickness: inches or Dia. 5 in. to 495 ft. depth gage No. 250 | |
| 5. Type and color of material | |
| From | To |
| CLAY | 0 39 |
| FINE SAND | 39 48 |
| GRAVEL | 48 58 |
| SHALE | 58 60 |
| 10. Screen: Manufacturer's name JESS & Lowell Type PLASTIC Dia. 5" Slot/gauze 1/16 Length 10' Set between 48 ft. and 58 ft. Gravel pack? YES Size range of material 1/4-5/8 | |
| 11. Static water level: 39 ft. below land surface Date 7/16/77 mo./day/yr. | |
| 12. Pumping level below land surfaces: NOT PUMPED 39' ft. after 19' hrs. pumping 19' g.p.m. Estimated maximum yield 19' g.p.m. | |
| 13. Water sample submitted: NOT IN OIL Yes <input checked="" type="checkbox"/> No <input type="checkbox"/> Date 7/16/77 mo./day/yr. | |
| 14. Well head completion: NO Pitless adapter NO Inches above grade | |
| 15. Well grouted? YES With: <input checked="" type="checkbox"/> Neat cement <input type="checkbox"/> Bentonite <input type="checkbox"/> Concrete Depth: From 6 ft. to 16 ft. | |
| 16. Nearest source of possible contamination: STOCK ft. 90 Direction NORTH Type LOTS Well disinfected upon completion? <input checked="" type="checkbox"/> Yes <input type="checkbox"/> No | |
| 17. Pump: <input checked="" type="checkbox"/> Not installed Manufacturer's name _____ Model number _____ HP _____ Volts _____ Length of drop pipe _____ ft. capacity _____ g.p.m. Type: <input type="checkbox"/> Submersible <input type="checkbox"/> Turbine <input type="checkbox"/> Jet <input type="checkbox"/> Reciprocating <input type="checkbox"/> Centrifugal <input type="checkbox"/> Other | |
| (Use a second sheet if needed) | |
| 18. Elevation: Topography: <input checked="" type="checkbox"/> Hill <input checked="" type="checkbox"/> Slope <input type="checkbox"/> Upland <input type="checkbox"/> Valley | 19. Remarks: CONCRETE SLAB TO BE INSTALLED BY CUSTOMER AT GROUND LEVEL. 20' (TOP) |
| 20. Water well contractor's certification: This well was drilled under my jurisdiction and this report is true to the best of my knowledge and belief. Business name D&L Drilling Co 303 License No. 13089328 Address HILL CITY, KS. 67642 Signed Alan Johnson Date 7-29-77 Authorized representative | |

1-8
2-3
1-5
NEW NEW NEW
1/4 1/4 1/4

Forward the white, blue and pink copies to the Department of Health and Environment

Form WWC-5