


1 LOCATION OF WATER WELL: Fraction SE Section Number 15 Township Number T 8 S Range Number R 23  
 County: Graham Distance and direction from nearest town or city street address of well if located within city? 2 miles west 1 half mile south of Hill City

2 WATER WELL OWNER: Casey Jones  
 RR#, St. Address, Box #: 517 N, 9th  
 City, State, ZIP Code: Hill City, Ks. 67642  
 Board of Agriculture, Division of Water Resources  
 Application Number:

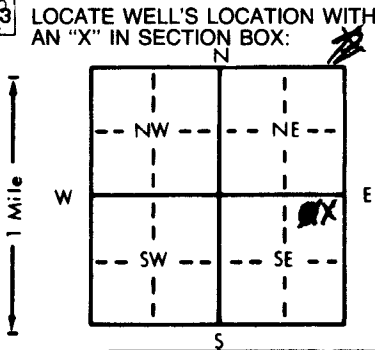

4 DEPTH OF COMPLETED WELL: 66 ft. ELEVATION: 43  
 Depth(s) Groundwater Encountered 1. 43 ft. 2. 48 ft. 3. 9-14-82 ft.  
 WELL'S STATIC WATER LEVEL 43 ft. below land surface measured on 9-14-82  
 Pump test data: Well water was 48 ft. after 1 hours pumping 20 gpm  
 Est. Yield 50 gpm; Well water was 48 ft. after 1 hours pumping 20 gpm  
 Bore Hole Diameter 8 in. to 66 ft., and 66 in. to 66 ft.  
 WELL WATER TO BE USED AS:  
 5 Public water supply 8 Air conditioning 11 Injection well  
 1 Domestic 3 Feedlot 6 Oil field water supply 9 Dewatering 12 Other (Specify below)  
 2 Irrigation 4 Industrial 7 Lawn and garden only 10 Observation well  
 Was a chemical/bacteriological sample submitted to Department? Yes X No X; If yes, mo/day/yr sample was submitted 9-14-82  
 Water Well Disinfected? Yes X No X

5 TYPE OF BLANK CASING USED:  
 1 Steel 3 RMP (SR) 5 Wrought iron 8 Concrete tile CASING JOINTS: Glued X Clamped X  
 2 PVC 4 ABS 6 Asbestos-Cement 9 Other (specify below) Welded X  
 7 Fiberglass Threaded X  
 Blank casing diameter 5 in. to 56 ft., Dia. 56 in. to 56 ft., Dia. 56 in. to 56 ft.  
 Casing height above land surface 12 in., weight 12 lbs./ft. Wall thickness or gauge No. 214  
 TYPE OF SCREEN OR PERFORATION MATERIAL:  
 1 Steel 3 Stainless steel 5 Fiberglass 8 RMP (SR) 10 Asbestos-cement  
 2 Brass 4 Galvanized steel 6 Concrete tile 9 ABS 11 Other (specify) 7 PVC  
 12 None used (open hole)  
 SCREEN OR PERFORATION OPENINGS ARE:  
 1 Continuous slot 3 Mill slot 5 Gauzed wrapped 8 Saw cut 11 None (open hole)  
 2 Louvered shutter 4 Key punched 6 Wire wrapped 9 Drilled holes  
 7 Torch cut 10 Other (specify) 7 PVC  
 SCREEN-PERFORATED INTERVALS: From 56 ft. to 66 ft., From 56 ft. to 66 ft.  
 GRAVEL PACK INTERVALS: From 15 ft. to 66 ft., From 15 ft. to 66 ft.

6 GROUT MATERIAL: 1 Neat cement 2 Cement grout 3 Bentonite 4 Other  
 Grout Intervals: From 5 ft. to 15 ft., From 15 ft. to 15 ft., From 15 ft. to 15 ft.  
 What is the nearest source of possible contamination:  
 1 Septic tank 4 Lateral lines 7 Pit privy 10 Livestock pens 14 Abandoned water well  
 2 Sewer lines 5 Cess pool 8 Sewage lagoon 11 Fuel storage 15 Oil well/Gas well  
 3 Watertight sewer lines 6 Seepage pit 9 Feedyard 12 Fertilizer storage 16 Other (specify below) 50'  
 13 Insecticide storage  
 Direction from well? \_\_\_\_\_ How many feet? \_\_\_\_\_

FROM	TO	LITHOLOGIC LOG	FROM	TO	LITHOLOGIC LOG
0	8	Top soil and fine sand			
8	36	Clay			
36	45	Clay and fine sand			
45	66	Fine sand and gravel			
66		Blue shale			

7 CONTRACTOR'S OR LANDOWNER'S CERTIFICATION: This water well was (1) constructed, (2) reconstructed, or (3) plugged under my jurisdiction and was completed on (mo/day/year) 9-14-82 and this record is true to the best of my knowledge and belief. Kansas Water Well Contractor's License No. 432 This Water Well Record was completed on (mo/day/yr) 9-28-82  
 under the business name of MARTY B DRILLING by (signature) Martin L. Brice

INSTRUCTIONS: Use typewriter or ball point pen, PLEASE PRESS FIRMLY and PRINT clearly. Please fill in blanks, underline or circle the correct answers. Send top three copies to Kansas Department of Health and Environment, Division of Environment, Environmental Geology Section, Topeka, KS 66620. Send one to WATER WELL OWNER and retain one for your records.

OFFICE USE ONLY T B R 23 E/W SEC 15 NE 1/4 NE 1/4 SE 1/4