


1 LOCATION OF WATER WELL: Fraction NW 1/4 NE 1/4 SW 1/4 Section Number 25 Township Number T 8 S Range Number R 23 **EW**

Distance and direction from nearest town or city street address of well if located within city?  
 2 1/2 miles South of Hill City

2 WATER WELL OWNER: Graham Co. Landfill  
 RR#, St. Address, Box # : Board of Agriculture, Division of Water Resources  
 City, State, ZIP Code : Hill City, Ks. 67642 #2 Application Number:

3 LOCATE WELL'S LOCATION WITH AN "X" IN SECTION BOX:

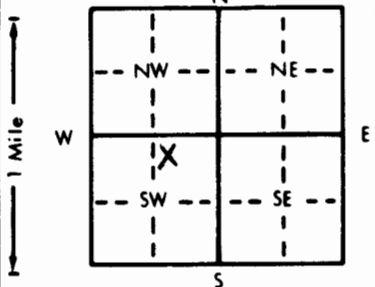

4 DEPTH OF COMPLETED WELL 39.49 ft. ELEVATION:  
 Depth(s) Groundwater Encountered 1. ft. 2. ft. 3. ft.  
 WELL'S STATIC WATER LEVEL 36.51 ft. below land surface measured on mo/day/yr  
 Pump test data: Well water was . ft. after . hours pumping . gpm  
 Est. Yield . gpm: Well water was . ft. after . hours pumping . gpm  
 Bore Hole Diameter . 8 . in. to . 39.49 . ft., and . in. to . ft.  
 WELL WATER TO BE USED AS: 5 Public water supply 8 Air conditioning 11 Injection well  
 1 Domestic 3 Feedlot 6 Oil field water supply 9 Dewatering 12 Other (Specify below)  
 2 Irrigation 4 Industrial 7 Lawn and garden only 10 Monitoring well  
 Was a chemical/bacteriological sample submitted to Department? Yes . No **X** .; If yes, mo/day/yr sample was submitted  
 Water Well Disinfected? Yes . No **X** .

5 TYPE OF BLANK CASING USED: 5 Wrought iron 8 Concrete tile CASING JOINTS: Glued . Clamped .  
 1 Steel 3 RMP (SR) 6 Asbestos-Cement 9 Other (specify below) Welded .  
 2 PVC 4 ABS 7 Fiberglass . Threaded. **X** .

Blank casing diameter . in. to . ft., Dia . in. to . ft., Dia . in. to . ft.  
 Casing height above land surface . 90 . in., weight . 2.071 . lbs./ft. Wall thickness or gauge No. . 237

TYPE OF SCREEN OR PERFORATION MATERIAL: 7 PVC 10 Asbestos-cement  
 1 Steel 3 Stainless steel 5 Fiberglass 8 RMP (SR) 11 Other (specify) .  
 2 Brass 4 Galvanized steel 6 Concrete tile 9 ABS 12 None used (open hole)

SCREEN OR PERFORATION OPENINGS ARE: 5 Gauzed wrapped 8 Saw cut 11 None (open hole)  
 1 Continuous slot 3 Mill slot 6 Wire wrapped 9 Drilled holes  
 2 Louvered shutter 4 Key punched 7 Torch cut 10 Other (specify) .

SCREEN-PERFORATED INTERVALS: From . 19.49 . ft. to . 39.49 . ft., From . ft. to . ft.  
 From . ft. to . ft., From . ft. to . ft.  
 GRAVEL PACK INTERVALS: From . 16 . ft. to . 39.49 . ft., From . ft. to . ft.  
 From . ft. to . ft., From . ft. to . ft.

6 GROUT MATERIAL: 1 Neat cement 2 Cement grout 3 Bentonite 4 Other .  
 Grout Intervals: From . 0 . ft. to . 16 . ft., From . ft. to . ft., From . ft. to . ft.

What is the nearest source of possible contamination:  
 1 Septic tank 4 Lateral lines 7 Pit privy 10 Livestock pens 14 Abandoned water well  
 2 Sewer lines 5 Cess pool 8 Sewage lagoon 11 Fuel storage 15 Oil well/Gas well  
 3 Watertight sewer lines 6 Seepage pit 9 Feedyard 12 Fertilizer storage 16 Other (specify below)  
 13 Insecticide storage . Landfill .

Direction from well? How many feet?

FROM	TO	LITHOLOGIC LOG	FROM	TO	PLUGGING INTERVALS
0	.5	Surface			
.5	1	Rock			
1	15	Fine to Med. Sand			
15	16	Clay			
16	19	Sand/Clay Strks.			
19	31	Silty Sand/Clay Strks.			
31	35	Clay & Sand Strks.			
35	39.49	Weathered Shale			

7 CONTRACTOR'S OR LANDOWNER'S CERTIFICATION: This water well was (1) constructed, (2) reconstructed, or (3) plugged under my jurisdiction and was completed on (mo/day/year) . 8-19-93 . and this record is true to the best of my knowledge and belief. Kansas Water Well Contractor's License No. . 554 . This Water Well Record was completed on (mo/day/yr) . 8-23-93 . under the business name of Woofter Pump & Well, Inc. by (signature) *Jay C. Woofter*

OFFICE USE ONLY  
 T  
 R  
 EW  
 SEC.