


1 LOCATION OF WATER WELL: Fraction SW 1/4 SW 1/4 NW 1/4 Section Number 36 Township Number T 8 S Range Number R 23 E/W  
 County: Graham  
 Distance and direction from nearest town or city street address of well if located within city?  
3 1/2 mile south of Hell City Kansas

2 WATER WELL OWNER: Buck Bethel  
 RR#, St. Address, Box # :  
 City, State, ZIP Code : Hell City Kansas  
 Board of Agriculture, Division of Water Resources  
 Application Number:

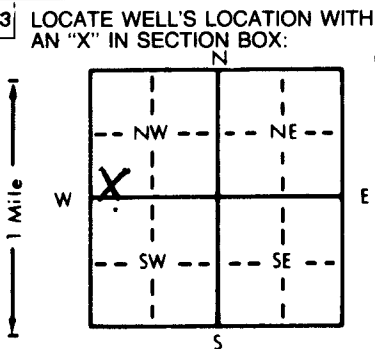

4 DEPTH OF COMPLETED WELL: 32 ft. ELEVATION:  
 Depth(s) Groundwater Encountered 1. 20 ft. 2. . . . . ft. 3. . . . . ft.  
 WELL'S STATIC WATER LEVEL: 20 ft. below land surface measured on mo/day/yr 6-18-93  
 Pump test data: Well water was . . . . . ft. after . . . . . hours pumping . . . . . gpm  
 Est. Yield 60 gpm: Well water was . . . . . ft. after . . . . . hours pumping . . . . . gpm  
 Bore Hole Diameter: 10 in. to 32 ft., and . . . . . in. to . . . . . ft.  
 WELL WATER TO BE USED AS:  
 1 Domestic  3 Feedlot  6 Oil field water supply  9 Dewatering  12 Other (Specify below)  
 2 Irrigation  4 Industrial  7 Lawn and garden only  10 Monitoring well  
 Was a chemical/bacteriological sample submitted to Department? Yes. . . . . No. ; If yes, mo/day/yr sample was submitted  
 Water Well Disinfected? Yes . . . . . No

5 TYPE OF BLANK CASING USED:  
 1 Steel  3 RMP (SR)  6 Asbestos-Cement  9 Other (specify below)  Welded  
 2 PVC  4 ABS  7 Fiberglass . . . . . Threaded  
 Blank casing diameter: 5 in. to 20 ft., Dia. . . . . in. to . . . . . ft., Dia. . . . . in. to . . . . . ft.  
 Casing height above land surface: 22 in., weight 160 lbs./ft. Wall thickness or gauge No. . . . .  
 TYPE OF SCREEN OR PERFORATION MATERIAL:  
 1 Steel  3 Stainless steel  5 Fiberglass  8 RMP (SR)  10 Asbestos-cement  
 2 Brass  4 Galvanized steel  6 Concrete tile  9 ABS  12 None used (open hole)  
 SCREEN OR PERFORATION OPENINGS ARE:  
 1 Continuous slot  3 Mill slot  6 Wire wrapped  9 Drilled holes  
 2 Louvered shutter  4 Key punched  7 Torch cut  10 Other (specify) . . . . .  
 SCREEN-PERFORATED INTERVALS: From 22 ft. to 32 ft., From . . . . . ft. to . . . . . ft.  
 From . . . . . ft. to . . . . . ft., From . . . . . ft. to . . . . . ft.  
 GRAVEL PACK INTERVALS: From 0 ft. to 22 ft., From . . . . . ft. to . . . . . ft.  
 From . . . . . ft. to . . . . . ft., From . . . . . ft. to . . . . . ft.

6 GROUT MATERIAL:  1 Neat cement  2 Cement grout  3 Bentonite  4 Other . . . . .  
 Grout Intervals: From 0 ft. to 22 ft., From . . . . . ft. to . . . . . ft., From . . . . . ft. to . . . . . ft.  
 What is the nearest source of possible contamination:  
 1 Septic tank  4 Lateral lines  7 Pit privy  10 Livestock pens  14 Abandoned water well  
 2 Sewer lines  5 Cess pool  8 Sewage lagoon  11 Fuel storage  15 Oil well/Gas well  
 3 Watertight sewer lines  6 Seepage pit  9 Feedyard  12 Fertilizer storage  16 Other (specify below)  
 13 Insecticide storage Another Well 50 feet south  
 Direction from well?  
 How many feet?

FROM	TO	LITHOLOGIC LOG	FROM	TO	PLUGGING INTERVALS
0	10	Surface Clay			
10	20	Hard Yellow Clay			
20	24	Hard Yellow Clay			
24	30	Large Water-logged Rock & Shale & Gravel			

7 CONTRACTOR'S OR LANDOWNER'S CERTIFICATION: This water well was (1) constructed, (2) reconstructed, or (3) plugged under my jurisdiction and was completed on (mo/day/year) 6-18-93 and this record is true to the best of my knowledge and belief. Kansas Water Well Contractor's License No. 444 This Water Well Record was completed on (mo/day/yr) 6-18-93 under the business name of Anderson Drilling by (signature) Andy Anderson

OFFICE USE ONLY  
 T  
 R  
 EW  
 SEC  
 1/4  
 1/4  
 1/4