


1 LOCATION OF WATER WELL: Fraction NE NE 1/4 NE 1/4 NE 1/4 Section Number 14 Township Number T 8 S Range Number R 23 E
 County: GRAHAM

Distance and direction from nearest town or city street address of well if located within city?
405 W MAIN

2 WATER WELL OWNER: Bobbie Bell
 RR#, St. Address, Box # : 405 W. MAIN
 City, State, ZIP Code : Hi Lo City KS 67642
 Board of Agriculture, Division of Water Resources
 Application Number:

3 LOCATE WELL'S LOCATION WITH AN "X" IN SECTION BOX: DEPTH OF COMPLETED WELL 25.20 ft. ELEVATION: ~~2193.27~~ 2193.27

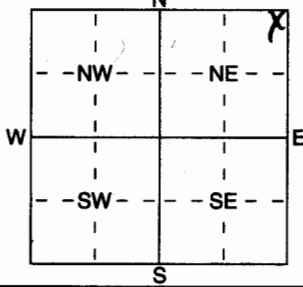

Depth(s) Groundwater Encountered 1 ft. 2 ft. 3 ft.
 WELL'S STATIC WATER LEVEL ft. below land surface measured on mo/day/yr
 Pump test data: Well water was ft. after hours pumping gpm
 Est. Yield gpm: Well water was ft. after hours pumping gpm
 WELL WATER TO BE USED AS: 5 Public water supply 8 Air conditioning 11 Injection well
 1 Domestic 3 Feedlot 6 Oil field water supply 9 Dewatering 12 Other (Specify below)
 2 Irrigation 4 Industrial 7 Domestic (lawn & garden) 10 Monitoring well U.B.W.-2

Was a chemical/bacteriological sample submitted to Department? Yes No; If yes, mo/day/yrs sample was submitted
 Water Well Disinfected? Yes No

5 TYPE OF BLANK CASING USED: 1 Steel 3 RMP (SR) 5 Wrought iron 8 Concrete tile CASING JOINTS: Glued Clamped
2 PVC 4 ABS 7 Fiberglass 9 Other (specify below) Welded
 Threaded

Blank casing diameter 4 in. to 1.0 ft., Dia in. to ft., Dia in. to ft.
 Casing height above land surface Flush mount in., weight lbs./ft. Wall thickness or guage No. SAH 40

TYPE OF SCREEN OR PERFORATION MATERIAL: 1 Steel 3 Stainless Steel 5 Fiberglass 7 PVC 10 Asbestos-Cement
 2 Brass 4 Galvanized Steel 6 Concrete tile 8 RMP (SR) 11 Other (Specify)
 12 None used (open hole)

SCREEN OR PERFORATION OPENINGS ARE: 1 Continuous slot 3 Mill slot 5 Gauzed wrapped 8 Saw cut 11 None (open hole)
 2 Louvered shutter 4 Key punched 6 Wire wrapped 9 Drilled holes
 7 Torch cut 10 Other (specify)


SCREEN-PERFORATED INTERVALS: From 10 ft. to 25.25 ft., From ft. to ft.
 From ft. to ft., From ft. to ft.
 GRAVEL PACK INTERVALS: From 8 ft. to 25.20 ft., From ft. to ft.
 From ft. to ft., From ft. to ft.

6 GROUT MATERIAL: 1 Neat cement 2 Cement grout 3 Bentonite 4 Other
 Grout Intervals: From D ft. to B ft., From ft. to ft., From ft. to ft.

What is the nearest source of possible contamination: 1 Septic tank 4 Lateral lines 7 Pit privy 11 Fuel storage 15 Oil well/Gas well
 2 Sewer lines 5 Cess pool 8 Sewage lagoon 12 Fertilizer storage 16 Other (specify below)
 3 Watertight sewer lines 6 Seepage pit 9 Feedyard 13 Insecticide storage
 Direction from well? How many feet? 25

FROM	TO	LITHOLOGIC LOG	FROM	TO	PLUGGING INTERVALS
		<u>SEE ATTACHED WELL LOG</u>			

7 CONTRACTOR'S OR LANDOWNER'S CERTIFICATION: This water well was (1) constructed, (2) reconstructed, or (3) plugged under my jurisdiction and was completed on (mo/day/year) SSU 4.22.04 and this record is true to the best of my knowledge and belief. Kansas Water Well Contractor's Licence No SSU. This Water Well Record was completed on (mo/day/yr) 6.15.04 under the business name of Wolfe & Sons Well by (signature) D Wolfe III

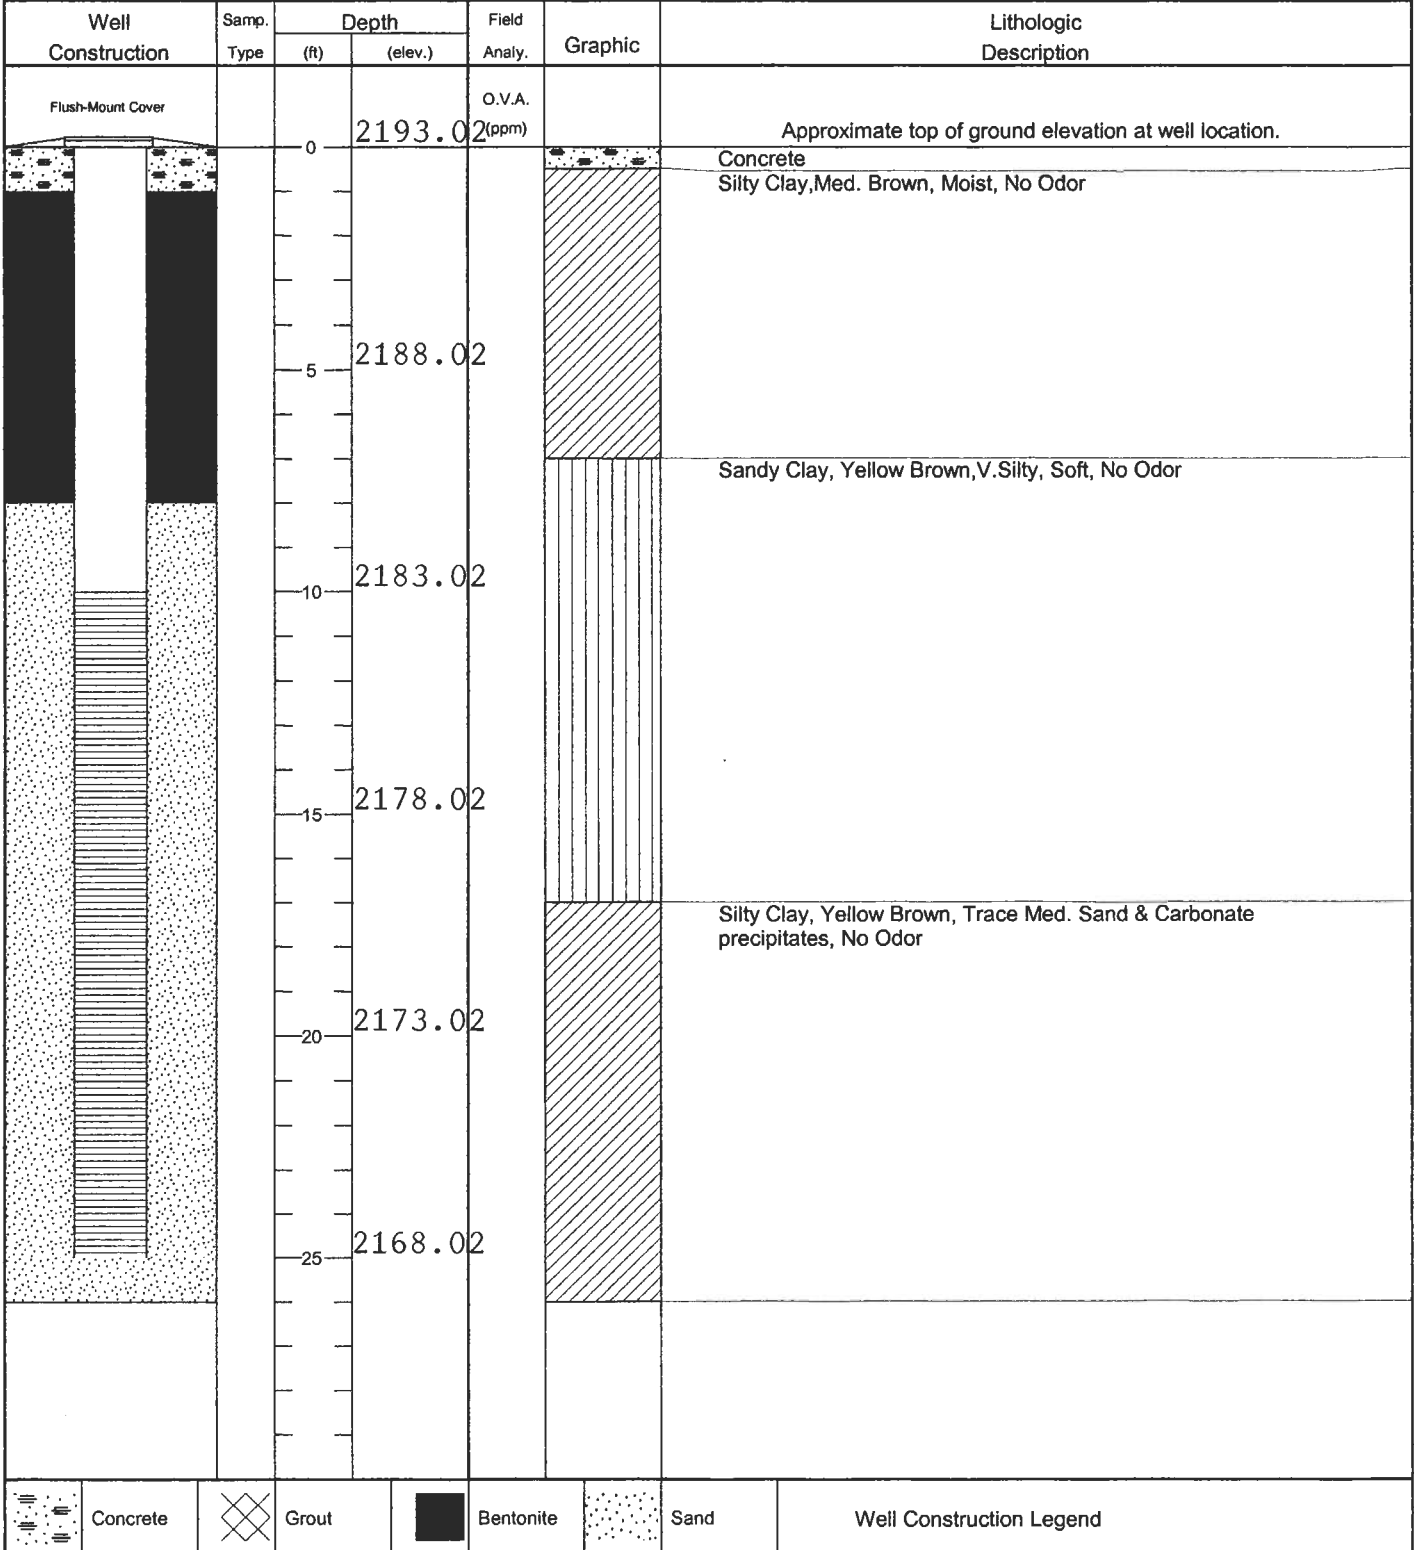

Well Construction Legend