


| | | | | | |
|---|-------------------------|-------------------------------|----------------|-----------------|---------------------|
| 1 | LOCATION OF WATER WELL: | Fraction | Section Number | Township Number | Range Number |
| | County: <u>Graham</u> | <u>NENE 1/4 NE 1/4 NE 1/4</u> | <u>14</u> | <u>8</u> | <u>23</u> EW |

Distance and direction from nearest town or city street address of well if located within city?

405 W Main St

| | | |
|---|---|---|
| 2 | WATER WELL OWNER: <u>Bobbie Bell</u> <u>405 W Main St</u> RR #, St. Address, Box #: <u>Hill City, KS 67642</u> City, State, ZIP Code : | Board of Agriculture, Division of Water Resources Application Number: <u>VEW-1</u> |
|---|---|---|

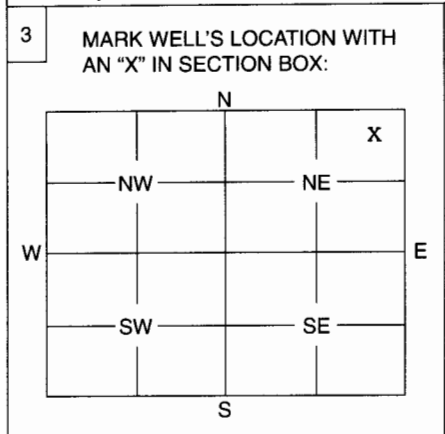

| | |
|---|--|
| 4 | DEPTH OF WELL <u>45.91</u> ft. WELL'S STATIC WATER LEVEL <u>42.23</u> ft. WELL WAS USED AS: 1 Domestic 2 Irrigation 3 Feedlot 4 Industrial 5 Public Water Supply 6 Oil Field Water Supply 7 Domestic (Lawn & Garden) 8 Air Conditioning 9 Dewatering <input checked="" type="checkbox"/> Monitoring Well VEW-1 11 Injection Well 12 Other |
|---|--|

Was a chemical / bacteriological sample submitted to Department? Yes No X.....
If yes, mo/day/yr sample was submitted

Water Well Disinfected: Yes No X.....

| | |
|---|---|
| 5 | TYPE OF BLANK CASING USED: 1 Steel <input checked="" type="checkbox"/> PVC 3 RMP (SR) 4 ABS 5 Wrought 6 Asbestos-Cement 7 Fiberglass 8 Concrete Tile 9 Other (Specify below) |
|---|---|

Blank casing diameter 4 in. Was casing pulled? Yes X No If yes, how much 13"
Casing height above or below land surface 18" in.

| | |
|---|---|
| 6 | GROUT PLUG MATERIAL: 1 Neat cement 2 Cement grout <input checked="" type="checkbox"/> Bentonite 4 Other |
|---|---|

Grout Plug Intervals: From 1.5 ft. to 45.91 ft., From ft. to ft., From to ft.

What is the nearest source of possible contamination:
1 Septic tank 6 Seepage pit Fuel storage 16 Other (specify below)

2 Sewer lines 7 Pit privy 12 Fertilizer storage

3 Watertight sewer lines 8 Sewage lagoon 13 Insecticide storage

4 Lateral lines 9 Feedyard 14 Abandoned water well

5 Cess pool 10 Livestock pens 15 Oil well/Gas well

Direction from well? Northwest How many feet? 15

| FROM | TO | PLUGGING MATERIALS |
|------|-------|-------------------------|
| 0 | 1.5 | Concrete |
| 1.5 | 45.91 | Volclay Bentonite Grout |
| | | |
| | | |
| | | |
| | | |

| | |
|---|--|
| 7 | CONTRACTOR'S OF LANDOWNER'S CERTIFICATION: This water well was plugged under my jurisdiction and was completed on (mo/day/year) <u>8-16-05</u> and this record is true to the best of my knowledge and belief. Kansas Water Well Contractor's License No. <u>735</u> This Water Well Record was completed on (mo/day/year) under the business name of <u>MILCO Environmental Services, Inc.</u> by (signature) <u>[Signature]</u> |
|---|--|

INSTRUCTIONS: Use typewriter or ball point pen. Please press firmly and print clearly. Please fill in blanks, underline or circle the correct answers. Send top three copies to Kansas Department of Health and Environment, Bureau of Water, Geology Section, 1000 SW Jackson St., Ste. 420, Topeka, Kansas 66612-1367. Telephone: 785/296-5522. Send one to Water Well Owner and retain one for your records.