

1 LOCATION OF WATER WELL:	Fraction	Section Number	Township Number	Range Number
County: <b>Graham</b>	<b>SE ¼ SE ¼ SE ¼</b>	<b>11</b>	<b>8S</b>	<b>23W</b>


Distance and direction from nearest town or city street address of well if located within city?

**406 W Main, Hill City, KS**

2 WATER WELL OWNER: **Dexter Potter**  
 RR#, St. Address, Box # **c/o First State Bank PO Box 369**  
 City, State, ZIP Code : **Hill City, KS 67642**

Board of Agriculture, Division of Water Resources  
 Application Number:

3 MARK WELL'S LOCATON WITH AN "X" IN SECTION BOX:

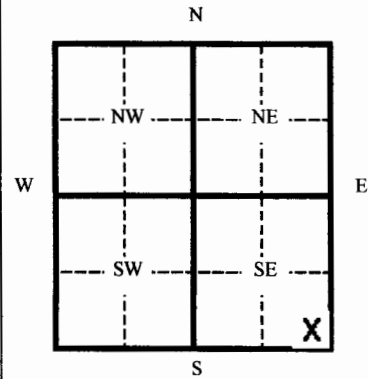

4 DEPTH OF WELL ..... **26** ft.

WELL'S STATIC WATER LEVEL ..... ft.

WELL WAS USED AS:

- |              |                              |   |
|--------------|------------------------------|---|
| 1 Domestic   | 5 Public Water Supply        | 9 Dewatering  |
| 2 Irrigation | 6 Oil Field Water Supply     | <input checked="" type="radio"/> 10 Monitoring Well |
| 3 Feedlot    | 7 Lawn and Garden (domestic) | 11 Injection Well                                   |
| 4 Industrial | 8 Air Conditioning           | 12 Other .....                                      |

Was a chemical/bacteriological sample submitted to Department? Yes ..... No **X**

If yes, mo/day/yr sample was submitted .....

Water Well Disinfected: Yes ..... No **X**

5 TYPE OF BLANK CASING USED:

1 Steel	3 RMP (SR)	5 Wrought	7 Fiberglass	9 Other (specify below)
<input checked="" type="radio"/> 2 PVC	4 ABC	6 Asbestos-Cement	8 Concrete Tile	

Blank casing diameter ..... **4** in. Was casing pulled? Yes **X** No ..... If yes, how much **20 FT**

Casing height above or below land surface ..... **-20 FT** in.

6 GROUT PLUG MATERIAL: 1 Neat cement  2 Cement grout  3 Bentonite 4 Other .....

GROUT PLUG INTERVALS: From **0** ft. to **3** ft. From **3** ft. to **26** ft. From ..... ft. to ..... ft.

What is the nearest source of possible contamination:

- |                          |                   |                         |                          |
|--------------------------|-------------------|-------------------------|--------------------------|
| 1 Septic tank            | 6 Seepage pit     | 11 Fuel storage         | 16 Other (specify below) |
| 2 Sewer lines            | 7 Pit privy       | 12 Fertilizer storage   | <b>Contaminated Site</b> |
| 3 Watertight sewer lines | 8 Sewage lagoon   | 13 Insecticide storage  |                          |
| 4 Lateral lines          | 9 Feedyard        | 14 Abandoned water well |                          |
| 5 Cess Pool              | 10 Livestock pens | 15 Oil well/ Gas well   |                          |

Direction from well? ..... How many feet? .....

FROM	TO	CODE	PLUGGING MATERIALS
<b>26</b>	<b>3</b>		<b>Bentonite</b>
<b>3</b>	<b>0</b>		<b>Cement</b>

7 CONTRACTOR'S OR LANDOWNER'S CERTIFICATION: This water well was plugged under my jurisdiction and was completed on (mo/day/yr) **10/24/05** and this record is true to the best of my knowledge and belief. Kansas Water Well Contractor's License No. **554** This Water Well Record was completed on (mo/day/yr) ..... under the business name of **Woofter Pump & Well Inc.**

by (signature) *Jay C. Woofter*

INSTRUCTIONS: Please fill in blanks and circle the correct answers. Send three copies to Kansas Department of Health and Environment, Bureau of Water, 1000 S W Jackson St., Ste. 420, Topeka, Kansas 66620-0001. Telephone: 785-296-3565. Send one to Water Well Owner and retain one for your records.