


1	LOCATION OF WATER WELL:	Fraction	Section Number	Township Number	Range Number
	County: Graham	NE 1/4 NE 1/4 NE 1/4	13	8	23 EW

Distance and direction from nearest town or city street address of well if located within city?
East Highway 24, Hill City

2 WATER WELL OWNER: **Doris Lovelady**
 RR #, St. Address, Box #: **RR 2, Box 201**
 City, State, ZIP Code: **Hill City, KS 67642**
 Board of Agriculture, Division of Water Resources
 Application Number:

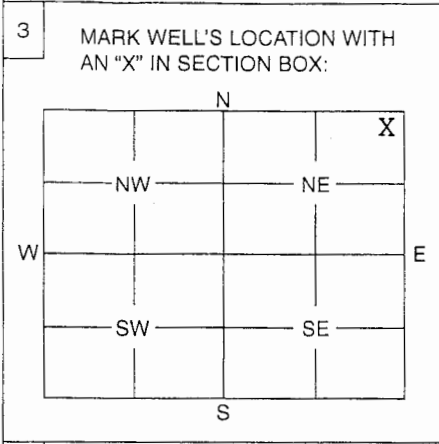

4 DEPTH OF WELL **25** ft.
 WELL'S STATIC WATER LEVEL **22.72** ft. **BTOC**
 WELL WAS USED AS:
 1 Domestic 5 Public Water Supply 9 Dewatering
 2 Irrigation 6 Oil Field Water Supply ⑩ Monitoring Well
 3 Feedlot 7 Domestic (Lawn & Garden) 11 Injection Well
 4 Industrial 8 Air Conditioning 12 Other

Was a chemical / bacteriological sample submitted to Department? Yes No **X**.....
 If yes, mo/day/yr sample was submitted

Water Well Disinfected: Yes No **X**.....

5 TYPE OF BLANK CASING USED:
 1 Steel 3 RMP (SR) 5 Wrought 7 Fiberglass 9 Other (Specify below)
 ② PVC 4 ABS 6 Asbestos-Cement 8 Concrete Tile

Blank casing diameter **2** in. Was casing pulled? Yes **X**..... No If yes, how much **25'**.....
 Casing height above or below land surface **n/a** in.

6 GROUT PLUG MATERIAL: 1 Neat cement 2 Cement grout ③ Bentonite ④ Other **Native soil**.....
 Grout Plug Intervals: From **0** ft. to **1** ft., From **1** ft. to **25** ft., From to ft.

What is the nearest source of possible contamination:
 1 Septic tank 6 Seepage pit ⑪ Fuel storage 16 Other (specify below)
 2 Sewer lines 7 Pit privy 12 Fertilizer storage

Direction from well? How many feet?

FROM	TO	PLUGGING MATERIALS
0	1	Native soil
1	20	Bentonite (8")
20	25	Bentonite (2")

MW 7
 GeoCore #832
 KDHE #U6 033 00625

7 CONTRACTOR'S OF LANDOWNER'S CERTIFICATION: This water well was plugged under my jurisdiction and was completed on (mo/day/year) **1-5-2006** and this record is true to the best of my knowledge and belief. Kansas Water Well Contractor's License No. **527** This Water Well Record was completed on (mo/day/year) **1-9-2006** under the business name of **GeoCore Inc.**
 by (signature) *Dale Hill*

INSTRUCTIONS: Use typewriter or ball point pen. ~~Please press firmly and print~~ clearly. Please fill in blanks, underline or circle the correct answers. Send top three copies to Kansas Department of Health and Environment, Bureau of Water, Geology Section, 1000 SW Jackson St., Ste. 420, Topeka, Kansas 66612-1367. Telephone: 785/296-5522. Send one to Water Well Owner and retain one for your records.