

Access

MORLAND

T R EW sec 1/4 1/4 1/4 No.

USE TYPEWRITER OR BALL POINT PEN-PRESS FIRMLY, PRINT CLEARLY.


WATER WELL RECORD KSA 82a-1201-1215

Location should be CAC (K65 B.O. # 7)

Kansas State Dept. Of Health (Water Well Contractors) Forbes-Bldg. 740 Topeka, Kansas 66620

1 Location of well: County **Prater** Township name **Solomon** Section number **18** Town number **8** Range number **24**

Distance and direction from nearest town or city: **1 1/2 mi East of Morland, Ko.** 3 Owner of well: **Jerry Rome Morland, Kansas**

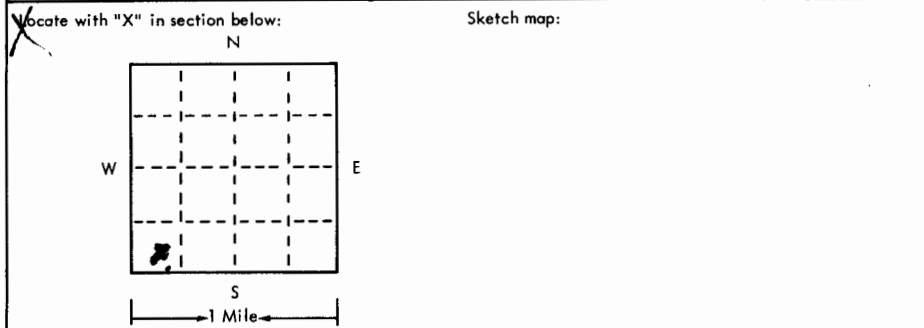

4 Well depth: **68** ft. Date of completion: **8-1-75**
Well diameter: **20** in.

5 Cable tool Rotary Driven Dug
 Hollow rod Jetted Bored Reverse rotary

6 Use: Domestic Public supply Industry
 Irrigation Air conditioning Commercial
 Test well

7 Casing: Material **Steel** Height: above/below
Threaded Welded Surface **12** in.
Diam. **12 3/4** Weight **33** lbs./ft.
0 in. to **68** ft. depth Drive shoe? Yes No

2	Type and color of material	From	To
	Fine sand - med. gravel	10	20
	Med Gravel	20	30
	Med Gravel	30	50
	Med. Gravel	50	55
	Med Gravel	55	64
	Med Gravel - Ocher	64	68
	BROCK 66		
	60		
	6's.s.		
	in Og		

8 Screen: Manufacturer **M.A. Brown**
Type **slotted** Dia. **12 3/4**
Slot/gauze **2-11** Length **29**
Set between **28** ft. and **48** ft.

Fittings: Gravel pack? Yes No Size range of material **4x58**

9 Static water level: **60** ft. below land surface Date **1-27-75**

10 Pumping level below land surfaces:
59 ft. after **10** hrs. pumping **1350** g.p.m.
ft. after _____ hrs. pumping _____ g.p.m.
Estimated maximum yield **1350** g.p.m.

11 Water sample submitted: Yes No Date _____

12 Well head completion: Pitless adapter **12** inches above grade

13 Well grouted? Yes No
 Neat cement Bentonite
Depth: From **0** ft. to **10** ft.

14 Nearest source of possible contamination: ft. _____ Direction _____ Type **None**
Well disinfected upon completion? Yes No

15 Pump: Not installed
Manufacturer's name **Hydro**
Model number **6300** HP _____ Volts _____
Length of drop pipe **60** ft. capacity **800** g.p.m.
Type: Submersible Turbine
 Jet Reciprocating
 Centrifugal Other

16 Remarks: elevation

Topography: Hill Slope Upland Valley

2287 (K65 B.O. # 7)
2221

17 Water well contractor's certification:
This well was drilled under my jurisdiction and this report is true to the best of my knowledge and belief.

Blair Jay Drilling Co. Inc. 214
Business name _____ License No. _____
Address **Box 503 Cely, Mo.**
Signed **Marlyn Roll** Date **6-21-75**
Authorized representative

8 9400 18 SE 5050