


1 LOCATION OF WATER WELL:	Fraction	Section Number	Township Number	Range Number
County: <u>Graham</u>	<u>NE 1/4 NW 1/4 NW 1/4 NE</u>	<u>23</u>	T <u>8</u> S	R <u>25</u> E <u>(W)</u>

Distance and direction from nearest town or city street address of well if located within city?

115 W. Main Morland, KS

2 WATER WELL OWNER:	RR#, St. Address, Box #	City, State, ZIP Code	Board of Agriculture, Division of Water Resources
<u>Faye Minium</u>	<u>P.O. Box 125</u>	<u>Morland, KS 67650</u>	Application Number:

3 LOCATE WELL'S LOCATION WITH AN "X" IN SECTION BOX:	4 DEPTH OF COMPLETED WELL	ELEVATION:
--	---------------------------	------------

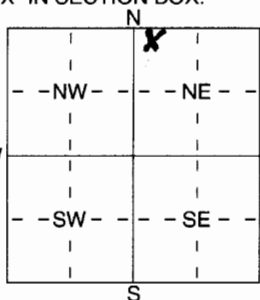

Depth(s) Groundwater Encountered	1	ft. 2	ft. 3
WELL'S STATIC WATER LEVEL	<u>18.59</u>	ft. below land surface measured on mo/day/yr	<u>3-30-06</u>
Pump test data:	Well water was	ft. after	hours pumping
Est. Yield	gpm: Well water was	ft. after	hours pumping
WELL WATER TO BE USED AS:	5 Public water supply	8 Air conditioning	11 Injection well
1 Domestic	3 Feedlot	6 Oil field water supply	9 Dewatering
2 Irrigation	4 Industrial	7 Domestic (lawn & garden)	10 Monitoring well
			<u>mw-8</u>

Was a chemical/bacteriological sample submitted to Department? Yes ..... No Y ..... If yes, mo/day/yr sample was submitted  
Water Well Disinfected? Yes ..... No

5 TYPE OF BLANK CASING USED:	5 Wrought iron	8 Concrete tile	CASING JOINTS: Glued	Clamped
1 Steel	3 RMP (SR)	6 Asbestos-Cement	9 Other (specify below)	Welded
2 PVC	4 ABS	7 Fiberglass		Threaded

Blank casing diameter ..... 2 in. to ..... 15 ft., Dia ..... in. to ..... ft., Dia ..... in. to ..... ft.  
Casing height above land surface ..... -0.43 in., weight ..... lbs./ft. Wall thickness or gauge No. ....

TYPE OF SCREEN OR PERFORATION MATERIAL:	10 Asbestos-Cement
1 Steel	3 Stainless Steel
2 Brass	4 Galvanized Steel
5 Fiberglass	8 RMP (SR)
6 Concrete tile	9 ABS
	11 Other (Specify)
	12 None used (open hole)

SCREEN OR PERFORATION OPENINGS ARE:	5 Gauzed wrapped	8 Saw cut	11 None (open hole)
1 Continuous slot	6 Wire wrapped	9 Drilled holes	
2 Louvered shutter	7 Torch cut	10 Other (specify)	ft.
3 Mill slot			
4 Key punched			

SCREEN-PERFORATED INTERVALS:	From	ft. to	ft., From	ft. to	ft.
	<u>15</u>	<u>25</u>			
GRAVEL PACK INTERVALS:	From	ft. to	ft., From	ft. to	ft.
	<u>13</u>	<u>25</u>			

6 GROUT MATERIAL:	1 Neat cement	2 Cement grout	3 Bentonite	4 Other
-------------------	---------------	----------------	-------------	---------

Grout Intervals: From ..... 0 ft. to ..... 13 ft., From ..... ft. to ..... ft., From ..... ft. to ..... ft.

What is the nearest source of possible contamination:	10 Livestock pens	14 Abandoned water well
1 Septic tank	4 Lateral lines	7 Pit privy
2 Sewer lines	5 Cess pool	8 Sewage lagoon
3 Watertight sewer lines	6 Seepage pit	9 Feedyard
		11 Fuel storage
		12 Fertilizer storage
		13 Insecticide storage
		15 Oil well/Gas well
		16 Other (specify below)

Direction from well? NW How many feet? 600

FROM	TO	LITHOLOGIC LOG	FROM	TO	PLUGGING INTERVALS
0	10	<u>Silty sand, f-med dk brn</u>			
10	18	<u>sand, med-coarse lt brn</u>			
		<u>w/ gray brn clay 13.5-15'</u>			
		<u>1" layers of caliche @ 14'</u>			
18	22	<u>coarse sand &amp; gravel, wet</u>			
		<u>w/ dark gray clay w/ yellow-green</u>			
		<u>streaks @ 20' moderate odor</u>			
22	25	<u>coarse sand &amp; gravel brn</u>			
		<u>wet &amp; trace clay/yellow ochre</u>			
		<u>no odor</u>			

7 CONTRACTOR'S OR LANDOWNER'S CERTIFICATION: This water well was (1) constructed, (2) reconstructed, or (3) plugged under my jurisdiction and was completed on (mo/day/year) ..... <u>3-23-06</u> ..... and this record is true to the best of my knowledge and belief. Kansas Water Well Contractor's Licence No ..... <u>554</u> ..... This Water Well Record was completed on (mo/day/yr) ..... <u>4/28/06</u> ..... under the business name of <u>Woofte Pump &amp; Well</u> by (signature) <u>Jay Woofte</u>
---