

1 LOCATION OF WATER WELL:	Fraction	Section Number	Township Number	Range Number
County: <u>Graham</u>	<u>NE 1/4 NW 1/4 NW 1/4 NE</u>	<u>23</u>	T <u>8</u> S	R <u>25</u> E <u>W</u>

Distance and direction from nearest town or city street address of well if located within city?

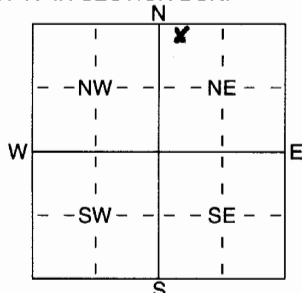
115 W. Main Morland, KS

2 WATER WELL OWNER:	Board of Agriculture, Division of Water Resources
RR#, St. Address, Box # :	Application Number:
City, State, ZIP Code :	

Faye MiniumP.O. Box 125Morland, KS 67650

3 LOCATE WELL'S LOCATION WITH	4 DEPTH OF COMPLETED WELL	ELEVATION:
-------------------------------	---------------------------	------------

AN "X" IN SECTION BOX:

Depth(s) Groundwater Encountered 1 ft. 2 3-30-06 ft. 3 3-30-06 ft.WELL'S STATIC WATER LEVEL 18.57 ft. below land surface measured on mo/day/yr 3-30-06Pump test data: Well water was 10 hours pumping gpmEst. Yield gpm: Well water was 10 hours pumping gpm

WELL WATER TO BE USED AS: 5 Public water supply 8 Air conditioning 11 Injection well

1 Domestic 3 Feedlot 6 Oil field water supply 9 Dewatering 12 Other (Specify below)

2 Irrigation 4 Industrial 7 Domestic (lawn & garden) 10 Monitoring well M.W. - 7Was a chemical/bacteriological sample submitted to Department? Yes No; If yes, mo/day/yr sample was submitted
Water Well Disinfected? Yes No

5 TYPE OF BLANK CASING USED:	5 Wrought iron	8 Concrete tile	CASING JOINTS: Glued <u>Clamped</u>
1 Steel	3 RMP (SR)	6 Asbestos-Cement	9 Other (specify below)
<u>2</u> PVC	4 ABS	7 Fiberglass	Welded <u>Threaded</u> <u>X</u>

Blank casing diameter 2 in. to 15 ft., Dia 15 in. to 15 ft., Dia 15 in. to 15 ft.Casing height above land surface 0.48 in., weight 15 lbs./ft. Wall thickness or guage No. 15

TYPE OF SCREEN OR PERFORATION MATERIAL:	5 Fiberglass	8 RMP (SR)	10 Asbestos-Cement
1 Steel	3 Stainless Steel	9 ABS	11 Other (Specify)
2 Brass	4 Galvanized Steel	6 Concrete tile	12 None used (open hole)

SCREEN OR PERFORATION OPENINGS ARE:	5 Guazed wrapped	8 Saw cut	11 None (open hole)
1 Continuous slot	6 Wire wrapped	9 Drilled holes	
<u>3</u> Mill slot	7 Torch cut	10 Other (specify)	
2 Louvered shutter			
4 Key punched			

SCREEN-PERFORATED INTERVALS:	From <u>15</u> ft. to <u>25</u> ft.	From <u>15</u> ft. to <u>25</u> ft.	From <u>15</u> ft. to <u>25</u> ft.
GRAVEL PACK INTERVALS:	From <u>13</u> ft. to <u>25</u> ft.	From <u>13</u> ft. to <u>25</u> ft.	From <u>13</u> ft. to <u>25</u> ft.

6 GROUT MATERIAL:	1 Neat cement	2 Cement grout	<u>3</u> Bentonite	4 Other
Grout Intervals:	From <u>0</u> ft. to <u>13</u> ft.	From <u>13</u> ft. to <u>25</u> ft.	From <u>25</u> ft. to <u>25</u> ft.	From <u>25</u> ft. to <u>25</u> ft.

What is the nearest source of possible contamination:	10 Livestock pens	14 Abandoned water well
1 Septic tank	4 Lateral lines	7 Pit privy
2 Sewer lines	5 Cess pool	8 Sewage lagoon
3 Watertight sewer lines	6 Seepage pit	9 Feedyard
		11 Fuel storage
		12 Fertilizer storage
		13 Insecticide storage
		15 Oil well/Gas well
		16 Other (specify below)

Direction from well? WNW How many feet? 80

FROM	TO	LITHOLOGIC LOG	FROM	TO	PLUGGING INTERVALS
<u>0</u>	<u>1</u>	<u>concrete</u>			
<u>1</u>	<u>7</u>	<u>clayey sand, dk brn</u>			
<u>7</u>	<u>14</u>	<u>sand, lt brn, f-med</u>			
		<u>w/trace coarse sand @ 13</u>			
<u>14</u>	<u>18</u>	<u>sand, med-coarse, lt brn, rust staining</u>			
<u>18</u>	<u>19</u>	<u>sand, Black, wet, strong odor</u>			
<u>19</u>	<u>25</u>	<u>sand, med-coarse w/ large</u>			
		<u>gravel, dark gray, wet, strong odor</u>			
		<u>mixed w/ lt brn sand & gravel +</u>			
		<u>yellow ochre @ 25-25</u>			

7 CONTRACTOR'S OR LANDOWNER'S CERTIFICATION: This water well was <u>(1)</u> constructed, (2) reconstructed, or (3) plugged under my jurisdiction and was completed on (mo/day/year) <u>3/23/06</u> and this record is true to the best of my knowledge and belief. Kansas Water Well Contractor's Licence No <u>554</u> This Water Well Record was completed on (mo/day/yr) <u>4/28/06</u> under the business name of <u>Woolf Pump & Well</u> by (signature) <u>Ray Woolf</u>
--