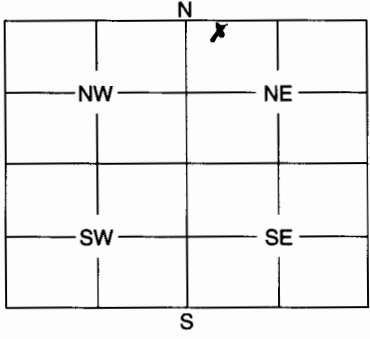


1	LOCATION OF WATER WELL: County: <u>GRAHAM</u>	Fraction <u>NE 1/4 NW 1/4 NW 1/4 NE</u>	Section Number <u>23</u>	Township Number <u>8</u>	Range Number <u>25</u> <span style="float: right;">EW</span>																								
Distance and direction from nearest town or city street address of well if located within city? <u>WEST MAIN &amp; FIRST STREET MORLAND</u>																													
2	WATER WELL OWNER: <u>CITIZEN STATE BANK</u> RR #, St. Address, Box #: <u>111 WEST MAIN</u> City, State, ZIP Code: <u>MORLAND KS 67050</u> Board of Agriculture, Division of Water Resources Application Number:																												
3	MARK WELL'S LOCATION WITH AN "X" IN SECTION BOX: <div style="text-align: center;">  </div>		4 DEPTH OF WELL <u>22.45</u> ft. WELL'S STATIC WATER LEVEL <u>19.10</u> ft. WELL WAS USED AS: <div style="display: flex; justify-content: space-between;"> <div> 1 Domestic 2 Irrigation 3 Feedlot 4 Industrial </div> <div> 5 Public Water Supply 6 Oil Field Water Supply 7 Domestic (Lawn &amp; Garden) 8 Air Conditioning </div> <div> 9 Dewatering  <u>10 Monitoring Well</u> <u>MW-4</u>  11 Injection Well  12 Other </div> </div> Was a chemical / bacteriological sample submitted to Department? Yes ..... No <u>X</u> If yes, mo/day/yr sample was submitted ..... Water Well Disinfected: Yes ..... No <u>X</u>																										
5	TYPE OF BLANK CASING USED: <div style="display: flex; justify-content: space-between;"> <div> 1 Steel <u>2 PVC</u> </div> <div> 3 RMP (SR) 4 ABS </div> <div> 5 Wrought 6 Asbestos-Cement </div> <div> 7 Fiberglass 8 Concrete Tile </div> <div> 9 Other (Specify below) </div> </div> Blank casing diameter <u>2</u> in. Was casing pulled? Yes <u>X</u> No ..... If yes, how much <u>22.45</u> Casing height above or below land surface ..... in.																												
6	GROUT PLUG MATERIAL: 1 Neat cement 2 Cement grout <u>3 Bentonite</u> 4 Other ..... Grout Plug Intervals: From <u>3</u> ft. to <u>22.45</u> ft., From ..... ft. to ..... ft., From ..... to ..... ft. What is the nearest source of possible contamination: <div style="display: flex; justify-content: space-between;"> <div> 1 Septic tank 2 Sewer lines 3 Watertight sewer lines 4 Lateral lines 5 Cess pool </div> <div> 6 Seepage pit 7 Pit privy 8 Sewage lagoon 9 Feedyard 10 Livestock pens </div> <div> 11 Fuel storage 12 Fertilizer storage 13 Insecticide storage 14 Abandoned water well 15 Oil well/Gas well </div> <div> 16 Other (specify below) <u>SURFACE</u> </div> </div> Direction from well? ..... How many feet? .....																												
<table border="1" style="width:100%; border-collapse: collapse;"> <thead> <tr> <th style="width:10%;">FROM</th> <th style="width:10%;">TO</th> <th style="width:80%;">PLUGGING MATERIALS</th> </tr> </thead> <tbody> <tr> <td><u>0</u></td> <td><u>3</u></td> <td><u>NATIVE SOIL</u></td> </tr> <tr> <td><u>3</u></td> <td><u>22.45</u></td> <td><u>BENTONITE SLURRY</u></td> </tr> <tr><td> </td><td> </td><td> </td></tr> <tr><td> </td><td> </td><td> </td></tr> <tr><td> </td><td> </td><td> </td></tr> <tr><td> </td><td> </td><td> </td></tr> <tr><td> </td><td> </td><td> </td></tr> </tbody> </table>						FROM	TO	PLUGGING MATERIALS	<u>0</u>	<u>3</u>	<u>NATIVE SOIL</u>	<u>3</u>	<u>22.45</u>	<u>BENTONITE SLURRY</u>															
FROM	TO	PLUGGING MATERIALS																											
<u>0</u>	<u>3</u>	<u>NATIVE SOIL</u>																											
<u>3</u>	<u>22.45</u>	<u>BENTONITE SLURRY</u>																											

RECEIVED

OCT 13 2006

BUREAU OF WATER

7 CONTRACTOR'S OF LANDOWNER'S CERTIFICATION: This water well was plugged under my jurisdiction and was completed on (mo/day/year) 9-25-06 and this record is true to the best of my knowledge and belief. Kansas Water Well Contractor's License No. 735 This Water Well Record was completed on (mo/day/year) 10-11-06 under the business name of MILCO ENVIRONMENTAL SERVICES INC by (signature) [Signature]

INSTRUCTIONS: Use typewriter or ball point pen. Please press firmly and print clearly. Please fill in blanks, underline or circle the correct answers. Send top three copies to Kansas Department of Health and Environment, Bureau of Water, Geology Section, 1000 SW Jackson St., Ste. 420, Topeka, Kansas 66612-1367. Telephone: 785/296-5522. Send one to Water Well Owner and retain one for your records.