


WATER WELL RECORD Form WWC-5 KSA 82a-1212

PLUGGED

1 LOCATION OF WATER WELL: County: SHERIDAN Fraction: SE 1/4 SW 1/4 NW 1/4 Section Number: 36 Township Number: T 8 S Range Number: R 26 EW

LEGAL CONFIRMED BY GMD 4

2 WATER WELL OWNER: RR#, St. Address, Box #, City, State, ZIP Code: FRANCES HANSON 6940 W 4 AVE LAKEWOOD CO 80226 PATRICIA LEAF 19762 6 PL NW WASHINGTON

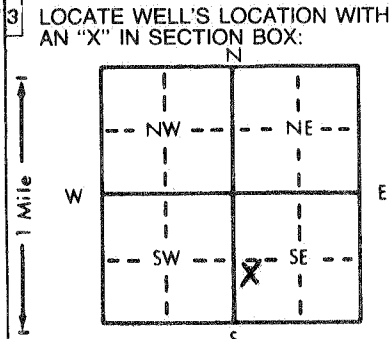

4 DEPTH OF COMPLETED WELL: 5 ft. WELL'S STATIC WATER LEVEL: 999 ft. below land surface measured on mo/day/yr

5 TYPE OF BLANK CASING USED: UNKNOWN. TYPE OF SCREEN OR PERFORATION MATERIAL: 1 Steel, 2 Brass, 3 Stainless steel, 4 Galvanized steel, 5 Fiberglass, 6 Concrete tile, 7 PVC, 8 RMP (SR), 9 ABS, 10 Asbestos-cement, 11 Other (specify) N/A, 12 None used (open hole)

6 GROUT MATERIAL: 1 Neat cement, 2 Cement grout, 3 Bentonite, 4 Other. Grout Intervals: From 5 ft. to 0 ft.

Table with columns: FROM, TO, LITHOLOGIC LOG, FROM, TO, PLUGGING INTERVALS. Includes Co OWNER: FREDRICK ENGEL, 204 MANOR DR, PACIFICA CA 94044.

7 CONTRACTOR'S OR LANDOWNER'S CERTIFICATION: This water well was (1) constructed, (2) reconstructed, or (3) plugged under my jurisdiction and was completed on (mo/day/year) 8-20-91 and this record is true to the best of my knowledge and belief.

INSTRUCTIONS: Use typewriter or ball point pen. PLEASE PRESS FIRMLY and PRINT clearly. Please fill in blanks, underline or circle the correct answers. Send top three copies to Kansas Department of Health and Environment, Bureau of Water, Topeka, Kansas 66620-0001.