


1 LOCATION OF WATER WELL: Fraction <sup>NW</sup> NW <sup>NE</sup> NE Section Number 6 Township Number T 8 S 9 Range Number R 27 E(W)

County: Sheridan Distance and direction from nearest town or city street address of well if located within city? 3 East 1/2 North of Hoxie

2 WATER WELL OWNER: Willis Toothaker RR#, St. Address, Box #: Rt. 1 City, State, ZIP Code: Hoxie, Ks. 67740 Board of Agriculture, Division of Water Resources Application Number:

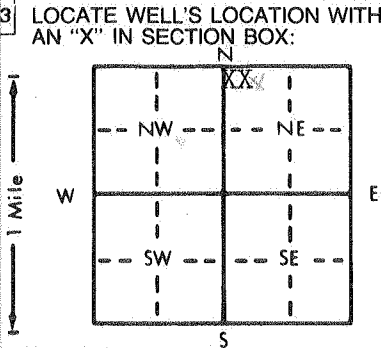

4 DEPTH OF COMPLETED WELL: 122 ft. ELEVATION: 122 ft. Depth(s) Groundwater Encountered: 1. 54 ft. 2. 84 ft. 3. 122 ft. WELL'S STATIC WATER LEVEL: 54 ft. below land surface measured on mo/day/yr 6-12-88. Pump test data: Well water was ... ft. after ... hours pumping ... gpm. Est. Yield ... gpm: Well water was ... ft. after ... hours pumping ... gpm. Bore Hole Diameter: 8.9 in. to 122 ft., and ... in. to ... ft. WELL WATER TO BE USED AS: 1 Domestic, 3 Feedlot, 6 Oil field water supply, 9 Dewatering, 12 Other (Specify below) Stook. 2 Irrigation, 4 Industrial, 7 Lawn and garden only, 10 Observation well. Was a chemical/bacteriological sample submitted to Department? Yes No X Y; If yes, mo/day/yr sample was submitted Water Well Disinfected? Yes No X X

5 TYPE OF BLANK CASING USED: 1 Steel, 2 PVC, 3 RMP (SR), 4 ABS, 5 Wrought iron, 6 Asbestos-Cement, 7 Fiberglass, 8 Concrete tile, 9 Other (specify below), CASING JOINTS: Glued X, Clamped, Welded, Threaded. Blank casing diameter: 4 1/2 in. to 102 ft., Dia 0.238 in. to 0.248 in. Casing height above land surface: 12 in., weight ... lbs./ft. Wall thickness or gauge No. TYPE OF SCREEN OR PERFORATION MATERIAL: 1 Steel, 2 Brass, 3 Stainless steel, 4 Galvanized steel, 5 Fiberglass, 6 Concrete tile, 7 PVC, 8 RMP (SR), 9 ABS, 10 Asbestos-cement, 11 Other (specify), 12 None used (open hole). SCREEN OR PERFORATION OPENINGS ARE: 1 Continuous slot, 2 Louvered shutter, 3 Mill slot, 4 Key punched, 5 Gauzed wrapped, 6 Wire wrapped, 7 Torch cut, 8 Saw cut, 9 Drilled holes, 10 Other (specify), 11 None (open hole). SCREEN-PERFORATED INTERVALS: From 102 ft. to 122 ft., From ... ft. to ... ft. GRAVEL PACK INTERVALS: From 20 ft. to 122 ft., From ... ft. to ... ft.

6 GROUT MATERIAL: 1 Neat cement, 2 Cement grout, 3 Bentonite, 4 Other. Grout Intervals: From 0 ft. to 20 ft., From ... ft. to ... ft. What is the nearest source of possible contamination: 1 Septic tank, 2 Sewer lines, 3 Watertight sewer lines, 4 Lateral lines, 5 Cess pool, 6 Seepage pit, 7 Pit privy, 8 Sewage lagoon, 9 Feedyard, 10 Livestock pens, 11 Fuel storage, 12 Fertilizer storage, 13 Insecticide storage, 14 Abandoned water well, 15 Oil well/Gas well, 16 Other (specify below) Plugged.

Direction from well? How many feet?

FROM	TO	LITHOLOGIC LOG	FROM	TO	LITHOLOGIC LOG
0	3	Surface			
3	9	Clay			
9	25	Med. sand			
25	32	Clay			
32	36	Caliche			
36	42	Med. sand			
42	58	Caliche			
58	64	Med. sand			
64	84	Clay			
84	102	Med. sand			
102	108	Clay			
108	122	Coarse gravel			

7 CONTRACTOR'S OR LANDOWNER'S CERTIFICATION: This water well was (1) constructed, (2) reconstructed, or (3) plugged under my jurisdiction and was completed on (mo/day/year) 6-12-88 and this record is true to the best of my knowledge and belief. Kansas Water Well Contractor's License No. 394 This Water Well Record was completed on (mo/day/yr) 6-29-88 under the business name of Woofter Pump & Well by (signature) [Signature]

INSTRUCTIONS: Use typewriter or ball point pen. PLEASE PRESS FIRMLY and PRINT clearly. Please fill in blanks, underline or circle the correct answers. Send top three copies to Kansas Department of Health and Environment, Bureau of Water Protection, Topeka, Kansas 66620-7320, Telephone: 913-862-9360. Send one to WATER WELL OWNER and retain one for your records.