

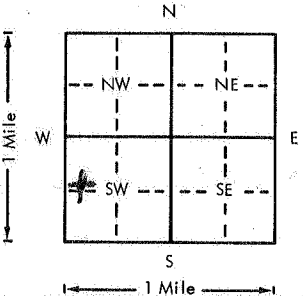
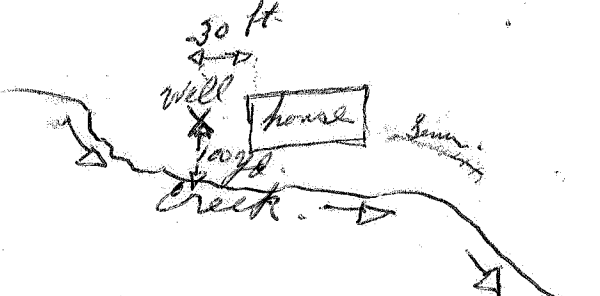
USE TYPEWRITER OR BALL POINT PEN—PRESS FIRMLY, PRINT CLEARLY.

45 ft
530
2250
2250
24750

WATER WELL RECORD
KSA 82a-1201-1215

Kansas Department of Health and Environment—Division of Environment
(Water well Contractors)
Topeka, Kansas 66620

CRB

1. Location of well: County: <u>Sheridan</u>		Fraction: <u>SW 1/4 NW 1/4 SW 1/4</u>		Section number: <u>12</u>		Township number: <u>T 8 S R 27</u>		Range number: <u>27</u>			
2. Distance and direction from nearest town or city: Street address of well location if in city: <u>3 M. E 1/4 N of 1/4 Josco Ko.</u>				3. Owner of well: <u>Jerry Cressler</u> R.R. or street: <u>Route No 1</u> City, state, zip code: <u>Hoxie, Kansas 67740</u>							
4. Locate with "X" in section below: 				Sketch map: 				6. Bore hole dia. <u>9 1/2</u> in. Completion date <u>7-10-78</u> Well depth <u>45</u> ft.			
				7. <input type="checkbox"/> Cable tool <input checked="" type="checkbox"/> Rotary <input type="checkbox"/> Driven <input type="checkbox"/> Dug <input type="checkbox"/> Hollow rod <input type="checkbox"/> Jetted <input type="checkbox"/> Bored <input type="checkbox"/> Reverse rotary				8. Use: <input checked="" type="checkbox"/> Domestic <input type="checkbox"/> Public supply <input type="checkbox"/> Industry <input type="checkbox"/> Irrigation <input type="checkbox"/> Air conditioning <input type="checkbox"/> Stock <input type="checkbox"/> Lawn <input type="checkbox"/> Oil field water <input type="checkbox"/> Other			
				9. Casing: Material <u>Plastic</u> Height: <u>Above</u> or below Threaded <input type="checkbox"/> Welded <input checked="" type="checkbox"/> Surface <u>14</u> in. RMP <input type="checkbox"/> PVC <input checked="" type="checkbox"/> Weight <u>215</u> lbs./ft. Dia. <u>5</u> in. to <u>45</u> ft. depth Wall Thickness: inches or Dia. <u>5</u> in. to <u>45</u> ft. depth gage Not <u>238</u>				10. Screen: Manufacturer's name <u>MODERN PIPE CO.</u> Type <u>PVC</u> Dia. <u>5 in.</u> Slot/gauze <u>5/16 in.</u> Length Set between <u>30</u> ft. and <u>45</u> ft. Gravel pack? <u>yes</u> Size range of material <u>5-1/4</u>			
5. Type and color of material				From		To		11. Static water level: _____ mo./day/yr. <u>28</u> ft. below land surface Date <u>7-10-78</u>			
<u>Blk Loam</u>				<u>0'</u>		<u>2'</u>		12. Pumping level below land surfaces: <u>35</u> ft. after <u>1</u> hrs. pumping <u>12</u> g.p.m. _____ ft. after _____ hrs. pumping _____ g.p.m. Estimated maximum yield <u>15</u> g.p.m.			
<u>clay yellow</u>				<u>2'</u>		<u>8'</u>		13. Water sample submitted: <u>1</u> <input checked="" type="checkbox"/> <u>think of</u> no./day/yr. _____ Yes <input checked="" type="checkbox"/> No <u>Day after date</u>			
<u>fine sand Redish Brn.</u>				<u>9'</u>		<u>10'</u>		14. Well head completion: <u>concrete</u> <input checked="" type="checkbox"/> Pitless adapter <u>14 1/2</u> inches above grade			
<u>yellow cavity</u>				<u>10'</u>		<u>13'</u>		15. Well grouted? <input checked="" type="checkbox"/> With: _____ Neat cement _____ Bentonite <input checked="" type="checkbox"/> Concrete Depth: From <u>0</u> ft. to <u>10</u> ft.			
<u>Redish Brn sand fine.</u>				<u>13'</u>		<u>28'</u>		16. Nearest source of possible contamination: ft. <u>100</u> Direction <u>SE</u> Type <u>sewer</u> Well disinfected upon completion? <input checked="" type="checkbox"/> Yes _____ No			
<u>finestone gray</u>				<u>28'</u>		<u>30'</u>		17. Pump: <input checked="" type="checkbox"/> Not installed Manufacturer's name _____ Model number _____ HP _____ Volts _____ Length of drop pipe _____ ft. capacity _____ g.p.m. Type: <input type="checkbox"/> Submersible <input type="checkbox"/> Turbine <input type="checkbox"/> Jet <input type="checkbox"/> Reciprocating <input type="checkbox"/> Centrifugal <input type="checkbox"/> Other			
<u>fine water gravel.</u>				<u>30'</u>		<u>42'</u>		20. Water well contractor's certification: This well was drilled under my jurisdiction and this report is true to the best of my knowledge and belief. 
<u>Blue shale</u>				<u>42'</u>		<u>45'</u>					
18. Elevation:											
19. Remarks: <u>Mr. Cressler was informed of grouting or sealing in upper part of casing or pitless adapter which he thinks he was going to install.</u>											

Forward the white, blue and pink copies to the Department of Health and Environment

Form WWC-5