

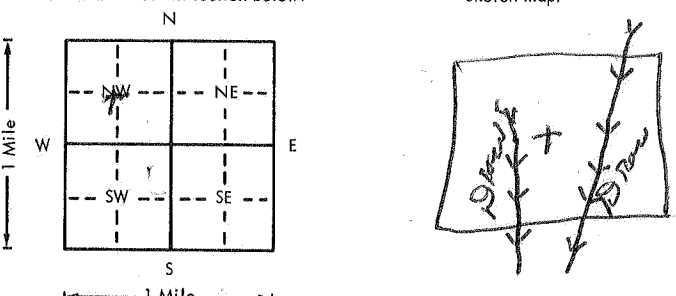
USE TYPEWRITER OR BALL POINT PEN—PRESS FIRMLY, PRINT CLEARLY.

HOXIE ZSE

WATER WELL RECORD
KSA 82a-1201-1215

Kansas Department of Health and Environment—Division of Environment
(Water well Contractors)
Topeka, Kansas 66620

BCA

1. Location of well: County <u>Sheridan</u> Fraction <u>NE 1/4 SW 1/4 NW 1/4</u> Section number <u>12</u> Township number <u>T 8 S R 27</u> Range number <u>27</u> E/W	
2. Distance and direction from nearest town or city: <u>1 W - 4 N - 1 E - 3 S</u> Street address of well location in city: <u>Miles 3 1/2</u> 3. Owner of well: <u>Larry Cressler</u> R.R. or street: City, state, zip code:	
4. Locate with "X" in section below: Sketch map: 	
5. Type and color of material	
Blk. Loam	From 0 To 2
Yellow Clay	2 12
Lime Stone Rock	12 18
Reddish Brown fine Sand	18 23
Lime stone Rock	23 40
Brown Med. fine sand	40 44
Tan Clay & Med. Gravel Mix	44 53
Grey Sandstone	53 62
Coarse Redish Brown Gravel	62 68
Clay & fine sand mix	68 70
Crouse Water Gravel	70 79
Limestone Rock	79 81
Med. Fine Sand	81 85
Red Tan Sandstone	85 104
Coarse Redish Brown Gravel	104 110
Yellow Sandstone	110 117
Blue shale	117 119
18. Elevation: Topography: <input type="checkbox"/> Hill <input type="checkbox"/> Slope <input checked="" type="checkbox"/> Upland <input type="checkbox"/> Valley	19. Remarks: <u>The above mentioned party was told of Platform + is going to run cement Platform + install windmill The only contamination is the cattle in Pasture 2535 (TOPO)</u>
6. Bore hole dia. <u>2 1/2</u> in. Completion date <u>3-16-77</u> Well depth <u>119</u> ft.	
7. <input type="checkbox"/> Cable tool <input checked="" type="checkbox"/> Rotary <input type="checkbox"/> Driven <input type="checkbox"/> Dug <input type="checkbox"/> Hollow rod <input type="checkbox"/> Jetted <input type="checkbox"/> Bored <input type="checkbox"/> Reverse rotary	
8. Use: <input type="checkbox"/> Domestic <input type="checkbox"/> Public supply <input type="checkbox"/> Industry <input type="checkbox"/> Irrigation <input type="checkbox"/> Air conditioning <input checked="" type="checkbox"/> Stock <input type="checkbox"/> Lawn <input type="checkbox"/> Oil field water <input type="checkbox"/> Other	
9. Casing: Material <u>Plastic</u> Height: <u>Above</u> or below Threading: <u>Welded</u> Surface <u>14</u> in. RMP: <u>PVC</u> Weight: <u>14</u> lbs./ft. Dia. <u>5</u> in. to <u>119</u> ft. depth Wall Thickness: inches or Dia. <u>5</u> in. to <u>119</u> ft. depth gage No. <u>258</u>	
10. Screen: Manufacturer's name: Type <u>PVC</u> Dia. <u>5"</u> Slot/gauze Length <u>30'</u> Set between <u>99</u> ft. and <u>119</u> ft. <u>71</u> ft. and <u>81</u> ft. Gravel pack? <input checked="" type="checkbox"/> Size range of material <u>1/8 - 1/4</u>	
11. Static water level: <u>46</u> ft. below land surface Date <u>3-16-77</u> mo./day/yr.	
12. Pumping level below land surfaces: <u>46</u> ft. after <u>1</u> hrs. pumping <u>10</u> g.p.m. <u>40</u> ft. after <u>1</u> hrs. pumping <u>40</u> g.p.m. Estimated maximum yield <u>40</u> g.p.m.	
13. Water sample submitted: <input checked="" type="checkbox"/> Yes <input type="checkbox"/> No Date	
14. Well head completion: <input type="checkbox"/> Pitless adapter <u>14</u> Inches above grade	
15. Well grouted? <u>Yes</u> With: <input type="checkbox"/> Neat cement <input type="checkbox"/> Bentonite <input checked="" type="checkbox"/> Concrete Depth: From <u>0</u> ft. to <u>10</u> ft.	
16. Nearest source of possible contamination: ft. Direction Type Well disinfected upon completion? <input checked="" type="checkbox"/> Yes <input type="checkbox"/> No	
17. Pump: <input checked="" type="checkbox"/> Not installed Manufacturer's name Model number HP Volts Length of drop pipe ft. capacity g.p.m. Type: <input type="checkbox"/> Submersible <input type="checkbox"/> Turbine <input type="checkbox"/> Jet <input type="checkbox"/> Reciprocating <input type="checkbox"/> Centrifugal <input type="checkbox"/> Other	
20. Water well contractor's certification: This well was drilled under my jurisdiction and this report is true to the best of my knowledge and belief. <u>PB Water Well Drilling Supply 294</u> Business name License No. Address <u>Hill City, Kans</u> Signed <u>Paul E. Brantley</u> Date <u>3/16/77</u> Authorized representative	

Forward the white, blue and pink copies to the Department of Health and Environment

Form WWC-5

1-8 27 12 NE SW NW 1/4 1/4 1/4