


1 LOCATION OF WATER WELL: Fraction NW 1/4 NE 1/4 Section Number 23 Township Number T 8 S Range Number R 27 **W**

County: SHERIDAN Distance and direction from nearest town or city street address of well if located within city? in Tasco, KS

2 WATER WELL OWNER: NW KS Groundwater Management Dist. #4 RR#, St. Address, Box #: P.O. Box 905 City, State, ZIP Code: Colby, KS 67701-0905 Board of Agriculture, Division of Water Resources WELL Application Number: SDA - 8

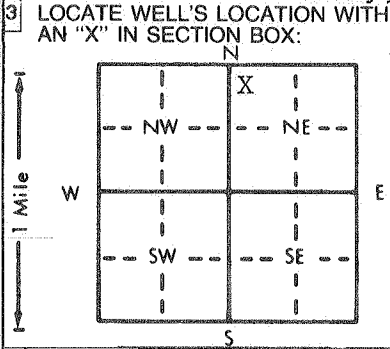

4 DEPTH OF COMPLETED WELL: 97 ft. ELEVATION: 2490 ft.

Depth(s) Groundwater Encountered 1. ft. 2. ft. 3. ft.

WELL'S STATIC WATER LEVEL . . . 9.6 . . . ft. below land surface measured on mo/day/yr 7-1-88

Pump test data: Well water was ft. after hours pumping gpm

Est. Yield gpm: Well water was ft. after hours pumping gpm

Bore Hole Diameter . . . 6 . . . in. to . . . 97 . . . ft., and in. to ft.

WELL WATER TO BE USED AS: 5 Public water supply 8 Air conditioning 11 Injection well
 1 Domestic 3 Feedlot 6 Oil field water supply 9 Dewatering 12 Other (Specify below)
 2 Irrigation 4 Industrial 7 Lawn and garden only 10 Monitoring well

Was a chemical/bacteriological sample submitted to Department? Yes No X; If yes, mo/day/yr sample was submitted Water Well Disinfected? Yes No

5 TYPE OF BLANK CASING USED: 1 Steel 3 RMP (SR) 5 Wrought iron 8 Concrete tile CASING JOINTS: Glued Clamped
 2 PVC 4 ABS 6 Asbestos-Cement 9 Other (specify below) Welded
 7 Fiberglass Threaded X flush

Blank casing diameter . . . 2 3/8 . . . in. to . . . 87 . . . ft., Dia in. to ft., Dia in. to ft.

Casing height above land surface . . . 24 . . . in., weight lbs./ft. Wall thickness or gauge No. sched. 40

TYPE OF SCREEN OR PERFORATION MATERIAL: 1 Steel 3 Stainless steel 5 Fiberglass X PVC 10 Asbestos-cement
 2 Brass 4 Galvanized steel 6 Concrete tile 9 ABS 11 Other (specify)
 12 None used (open hole)

SCREEN OR PERFORATION OPENINGS ARE: 1 Continuous slot 3 Mill slot 5 Gauzed wrapped X Saw cut .010 11 None (open hole)
 2 Louvered shutter 4 Key punched 6 Wire wrapped 9 Drilled holes
 7 Torch cut 10 Other (specify)

SCREEN-PERFORATED INTERVALS: From . . . 97 . . . ft. to . . . 87 . . . ft., From ft. to ft.
 From ft. to ft., From ft. to ft.

GRAVEL PACK INTERVALS: From . . . 97 . . . ft. to . . . 85 . . . ft., From ft. to ft.
 From ft. to ft., From ft. to ft.

6 GROUT MATERIAL: 1 Neat cement 2 Cement grout 3 Bentonite 4 Other 3/8 in. HOLE PLUG chips

Grout Intervals: From . . . 85 . . . ft. to . . . 0 . . . ft., From ft. to ft., From ft. to ft.

What is the nearest source of possible contamination: 1 Septic tank 4 Lateral lines 7 Pit privy 10 Livestock pens 14 Abandoned water well
 2 Sewer lines 5 Cess pool 8 Sewage lagoon 11 Fuel storage 15 Oil well/Gas well
 3 Watertight sewer lines 6 Seepage pit X Feedyard 12 Fertilizer storage X Other (specify below)
 13 Insecticide storage . . . Grain Storage

Direction from well? 9. 50 ft. S. 16. 100 ft. NW How many feet?

FROM	TO	LITHOLOGIC LOG	FROM	TO	PLUGGING INTERVALS
0	3	surface			
X 3	14	sandy clay			
14	23	medium sand			
23	25	clay			
25	42	medium sand			
42	61	blue clay			
61	98	medium sand w/ clay streaks			
98	105	shale			

7 CONTRACTOR'S OR LANDOWNER'S CERTIFICATION: This water well was (1) constructed, (2) reconstructed, or (3) plugged under my jurisdiction and was completed on (mo/day/year) June 29, 1988 and this record is true to the best of my knowledge and belief. Kansas Water Well Contractor's License No. 394 This Water Well Record was completed on (mo/day/yr) 8-5-88 under the business name of Woofter Pump and Well by (signature) Walt Woofter