

LOCATION OF WATER WELL: County: <u>Sheridan</u>	Fraction <u>NW 1/4 SW 1/4 NW 1/4</u>	Section Number <u>25</u>	Township Number <u>T 8 S</u>	Range Number <u>R 27 W E/W</u>
--	---	-----------------------------	---------------------------------	-----------------------------------

Distance and direction from nearest town or city street address of well if located within city?
 N/A - LOCATION CONFIRMED BY GMD #4

WATER WELL OWNER: <u>Glen R. Brown</u> RR#, St. Address, Box #: <u>RR 2 Box 35</u> City, State, ZIP Code: <u>Hoxie, KS 67740</u>	<u>Glen R. & Molly Brown</u> <u>P. O. Box 712</u> <u>Hoxie, KS 67740</u>	Board of Agriculture, Division of Water Resources Application Number:
--	--	--

LOCATE WELL'S LOCATION WITH AN "X" IN SECTION BOX:	DEPTH OF COMPLETED WELL. <u>103'</u> ft. ELEVATION:
--	---

Depth(s) Groundwater Encountered 1. 70' ft. 2. ft. 3. ft.

WELL'S STATIC WATER LEVEL ft. below land surface measured on mo/day/yr

Pump test data: Well water was ft. after hours pumping gpm

Est. Yield gpm: Well water was ft. after hours pumping gpm

Bore Hole Diameter in. to ft., and in. to ft.

WELL WATER TO BE USED AS:

<input checked="" type="checkbox"/> 1 Domestic	<input type="checkbox"/> 3 Feedlot	<input type="checkbox"/> 6 Oil field water supply	<input type="checkbox"/> 9 Dewatering	<input type="checkbox"/> 12 Other (Specify below)
<input type="checkbox"/> 2 Irrigation	<input type="checkbox"/> 4 Industrial	<input type="checkbox"/> 7 Lawn and garden only	<input type="checkbox"/> 10 Monitoring well	

Was a chemical/bacteriological sample submitted to Department? Yes.....No.....; If yes, mo/day/yr sample was submitted

Water Well Disinfected? Yes No

TYPE OF BLANK CASING USED:	5 Wrought iron	8 Concrete tile	CASING JOINTS: Glued Clamped
<input checked="" type="checkbox"/> 1 Steel	3 RMP (SR)	6 Asbestos-Cement	9 Other (specify below) Welded
2 PVC	4 ABS	7 Fiberglass	Threaded

Blank casing diameter 5 in. to ft., Dia in. to ft., Dia in. to ft.

Casing height above land surface 14 in., weight lbs./ft. Wall thickness or gauge No.

TYPE OF SCREEN OR PERFORATION MATERIAL:	7 PVC	10 Asbestos-cement
1 Steel	3 Stainless steel	5 Fiberglass
2 Brass	4 Galvanized steel	6 Concrete tile
		8 RMP (SR)
		9 ABS
		11 Other (specify)
		12 None used (open hole)

SCREEN OR PERFORATION OPENINGS ARE:	5 Gauzed wrapped	8 Saw cut	11 None (open hole)
1 Continuous slot	3 Mill slot	6 Wire wrapped	9 Drilled holes
2 Louvered shutter	4 Key punched	7 Torch cut	10 Other (specify)

SCREEN-PERFORATED INTERVALS: From ft. to ft., From ft. to ft.

GRAVEL PACK INTERVALS: From ft. to ft., From ft. to ft.

GROUT MATERIAL:	1 Neat cement	2 Cement grout	3 Bentonite	4 Other
-----------------	---------------	----------------	-------------	---------------


Grout Intervals: From ft. to ft., From ft. to ft., From ft. to ft.

What is the nearest source of possible contamination:

1 Septic tank	4 Lateral lines	7 Pit privy	10 Livestock pens	14 Abandoned water well
2 Sewer lines	5 Cess pool	8 Sewage lagoon	11 Fuel storage	15 Oil well/Gas well
3 Watertight sewer lines	6 Seepage pit	9 Feedyard	12 Fertilizer storage	16 Other (specify below)
			13 Insecticide storage	

Direction from well? How many feet?

FROM	TO	LITHOLOGIC LOG	FROM	TO	PLUGGING INTERVALS
			<u>103'</u>	<u>4'</u>	103 to 4' sand
			<u>4'</u>	<u>1'</u>	Bentonite clay
			<u>1'</u>	Surface	Dirt
		PLUGGING			
		INFORMATION			
		AT			
		RIGHT			

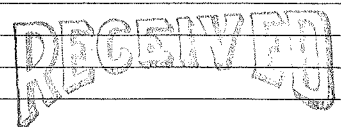

FEB 07 1990

DIVISION OF ENVIRONMENT

CONTRACTOR'S OR LANDOWNER'S CERTIFICATION: This water well was (1) constructed, (2) reconstructed, or (3) plugged under my jurisdiction and was completed on (mo/day/year) and this record is true to the best of my knowledge and belief. Kansas Water Well Contractor's License No. This Water Well Record was completed on (mo/day/yr) 1-2-1990 under the business name of by (signature) Glen R. Brown