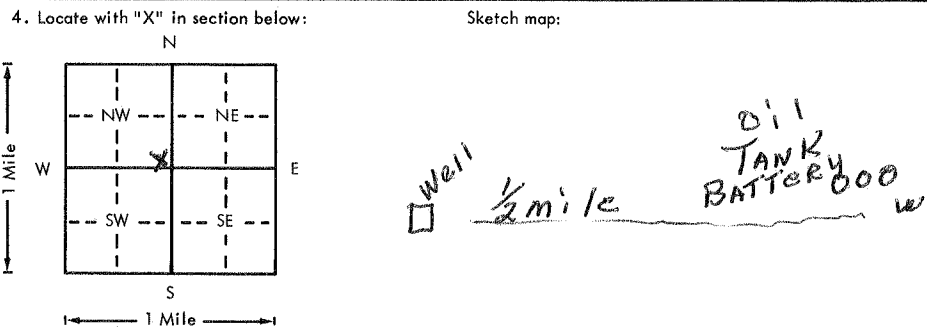


USE TYPEWRITER OR BALL POINT PEN-PRESS FIRMLY, PRINT CLEARLY.

WATER WELL RECORD
KSA 82a-1201-1215

Kansas Department of Health and Environment-Division of Environment
(Water well Contractors)
Topeka, Kansas 66620

BDD

| | |
|--|----------------|
| 1. Location of well: County SHERIDAN Fraction SE 1/4 SE 1/4 NW 1/4 Section number 35 Township number T 8 S Range number R 27 W | |
| 2. Distance and direction from nearest town or city: 3 miles South of TASCOC, KS. + 1/2 WEST. 3. Owner of well: JERRY GOETZ R.F.D. R.R. or street: PARK, KS, 67751 City, state, zip code: PARK, KS, 67751 | |
| 4. Locate with "X" in section below: Sketch map:  | |
| 6. Bore hole dia. 9 in. Completion date 5-2-77 Well depth 127 ft. | |
| 7. <input type="checkbox"/> Cable tool <input checked="" type="checkbox"/> Rotary <input type="checkbox"/> Driven <input type="checkbox"/> Dug <input type="checkbox"/> Hollow rod <input type="checkbox"/> Jetted <input type="checkbox"/> Bored <input type="checkbox"/> Reverse rotary | |
| 8. Use: <input checked="" type="checkbox"/> Domestic <input type="checkbox"/> Public supply <input type="checkbox"/> Industry <input type="checkbox"/> Irrigation <input type="checkbox"/> Air conditioning <input type="checkbox"/> Stock <input type="checkbox"/> Lawn <input type="checkbox"/> Oil field water <input type="checkbox"/> Other | |
| 9. Casing: Material PIST Height: Above or below Threading <input type="checkbox"/> Welded 91 Surface 2' in. RMP <input checked="" type="checkbox"/> PVC <input type="checkbox"/> Weight _____ lbs./ft. Dia. 5 in. to _____ ft. depth Wall Thickness: inches or Dia. _____ in. to _____ ft. depth gage No. 1250 | |
| 5. Type and color of material | |
| | From To |
| CLAY | 0 38 |
| SAND | 38 47 |
| CLAY + ROCK ledges | 47 95 |
| SANDY & CLAY | 95 99 |
| SAND & ROCK ledges | 99 114 |
| CLAY (SANDY) | 114 127 |
| BROCK ? | |
| 10. Screen: Manufacturer's name Jess & Lowell Type plastic Dia. 5" Sig/gauze 1/16 Length 10' Set between 117 ft. and 127 ft. Gravel pack? <input checked="" type="checkbox"/> Size range of material 1/4 - 5/8 | |
| 11. Static water level: _____ mo./day/yr. 97 ft. below land surface Date 5-2-77 | |
| 12. Pumping level below land surfaces: NOT PUMPED _____ ft. after _____ hrs. pumping _____ g.p.m. _____ ft. after _____ hrs. pumping _____ g.p.m. Estimated maximum yield _____ g.p.m. | |
| 13. Water sample submitted: _____ mo./day/yr. Yes <input checked="" type="checkbox"/> No <input type="checkbox"/> Date _____ | |
| 14. Well head completion: NOT done _____ Pitless adapter _____ Inches above grade | |
| 15. Well grouted? yes With: <input checked="" type="checkbox"/> Neat cement <input type="checkbox"/> Bentonite <input type="checkbox"/> Concrete Depth: From 0 ft. to 10 ft. | |
| 16. Nearest source of possible contamination: 1/2 mile Direction WEST Type OIL TANKS Well disinfected upon completion? <input checked="" type="checkbox"/> Yes <input type="checkbox"/> No | |
| 17. Pump: <input checked="" type="checkbox"/> Not installed Manufacturer's name _____ Model number _____ HP _____ Volts _____ Length of drop pipe _____ ft. capacity _____ g.p.m. Type: _____ Submersible _____ Turbine _____ Jet _____ Reciprocating _____ Centrifugal _____ Other _____ | |
| 18. Elevation: _____ 19. Remarks: OWNER TO INSTALL CONCRETE SLAB AT GROUND SURFACE. 20. Water well contractor's certification: This well was drilled under my jurisdiction and this report is true to the best of my knowledge and belief. D&L Drilling Co 303 Business name License No. Address Box 368 Hill City, KS. 67347 Signed Allan L. Brown Date 3/4/77 Authorized representative | |

Forward the white, blue and pink copies to the Department of Health and Environment

Form WWC-5