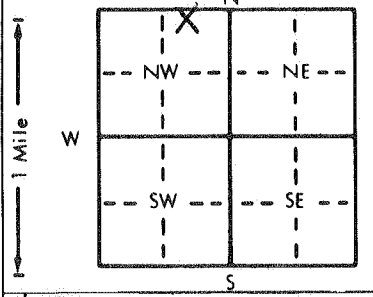


1 LOCATION OF WATER WELL: Fraction NE 1/4 NE 1/4 NW 1/4 Section Number 16 Township Number T 8 S Range Number R 28 E/W
 County: Sheridan

Distance and direction from nearest town or city street address of well if located within city?
1 Mile West of Hoxie 2 Acre Track in Lot 1 & 3, Blk 1 Shatzell Ind. Park

2 WATER WELL OWNER: Dale C. Woofter
 RR#, St. Address, Box #: Rt. 1 Box 109 Board of Agriculture, Division of Water Resources
 City, State, ZIP Code: Hoxie, Ks. 67740 Application Number:

3 LOCATE WELL'S LOCATION WITH AN "X" IN SECTION BOX:


4 DEPTH OF COMPLETED WELL: 216 ft. ELEVATION:
 Depth(s) Groundwater Encountered 1. ft. 2. ft. 3. ft.
 WELL'S STATIC WATER LEVEL: 122 ft. below land surface measured on mo/day/yr
 Pump test data: Well water was ft. after hours pumping gpm
 Est. Yield gpm: Well water was ft. after hours pumping gpm
 Bore Hole Diameter: 8 in. to 216 ft., and in. to ft.
 WELL WATER TO BE USED AS:
 5 Public water supply 8 Air conditioning 11 Injection well
 1 Domestic 3 Feedlot 6 Oil field water supply 9 Dewatering 12 Other (Specify below)
 2 Irrigation 4 Industrial 7 Lawn and garden only 10 Monitoring well
 Was a chemical/bacteriological sample submitted to Department? Yes No X; If yes, mo/day/yr sample was submitted
 Water Well Disinfected? Yes X No

5 TYPE OF BLANK CASING USED:
 1 Steel 3 RMP (SR) 5 Wrought iron 8 Concrete tile CASING JOINTS: Glued X Clamped
 2 PVC 4 ABS 6 Asbestos-Cement 9 Other (specify below) Welded
 7 Fiberglass Threaded
 Blank casing diameter: 4.5 in. to 162 ft., Dia. in. to ft., Dia. in. to ft.
 Casing height above land surface: 18 in., weight 2.38 lbs./ft. Wall thickness or gauge No. 248
 TYPE OF SCREEN OR PERFORATION MATERIAL:
 1 Steel 3 Stainless steel 5 Fiberglass 7 PVC 10 Asbestos-cement
 2 Brass 4 Galvanized steel 6 Concrete tile 8 RMP (SR) 11 Other (specify)
 9 ABS 12 None used (open hole)
 SCREEN OR PERFORATION OPENINGS ARE:
 5 Gauzed wrapped 8 Saw cut 11 None (open hole)
 1 Continuous slot 3 Mill slot 6 Wire wrapped 9 Drilled holes
 2 Louvered shutter 4 Key punched 7 Torch cut 10 Other (specify)
 SCREEN-PERFORATED INTERVALS: From 162 ft. to 216 ft., From ft. to ft.
 From ft. to ft., From ft. to ft.
 GRAVEL PACK INTERVALS: From 20 ft. to 216 ft., From ft. to ft.
 From ft. to ft., From ft. to ft.

6 GROUT MATERIAL: 1 Neat cement 2 Cement grout 3 Bentonite 4 Other
 Grout Intervals: From 0 ft. to 20 ft., From ft. to ft., From ft. to ft.
 What is the nearest source of possible contamination:
 1 Septic tank 4 Lateral lines 7 Pit privy 10 Livestock pens 14 Abandoned water well
 2 Sewer lines 5 Cess pool 8 Sewage lagoon 11 Fuel storage 15 Oil well/Gas well
 3 Watertight sewer lines 6 Seepage pit 9 Feedyard 12 Fertilizer storage 16 Other (specify below)
 13 Insecticide storage NONE

Direction from well?			How many feet?		
FROM	TO	LITHOLOGIC LOG	FROM	TO	PLUGGING INTERVALS
0	2	Surface	140	151	Med. Sand w/Clay Strks.
2	20	Loess	151	155	Sandy Clay
20	45	Sandy Clay w/Sand Strks.	155	158	Med. Sand w/Clay Strks.
45	56	Med. Sand w/Clay Strks.	158	160	Sticky Clay
56	62	Sandy Clay w/Caliche & Sand St	160	164	Sandy Clay
62	76	Sandy Clay & Caliche w/Cem.Sand	164	168	Fine Sand & Sandy Clay
76	80	Cemented Sand w/C.San&Sand St.	168	169	Hard Caliche
80	92	Sandy Clay w/Sand Strks.	169	171	Sandy Clay
92	101	Med. Sand w/Clay Strks.	171	178	Sandy Clay w/Med. Sand Strks
101	112	Tight Med. Sand w/Clay Strks.	178	188	Sticky Clay
112	122	Clay & Caliche w/Some Sand	188	192	Med. Sand w/Clay Strks.
122	129	Med. Sand w/Clay Strks.	192	198	Sticky Clay
129	130	Caliche	198	210	Med. Sand & Gravel w/Clay St
130	136	Tight Med. Sand w/Clay	210	214	Ochra
136	140	Sandy Clay & Caliche	214	216	Black Shale

7 CONTRACTOR'S OR LANDOWNER'S CERTIFICATION: This water well was (1) constructed, (2) reconstructed, or (3) plugged under my jurisdiction and was completed on (mo/day/year) 9-30-95 and this record is true to the best of my knowledge and belief. Kansas Water Well Contractor's License No. 554 This Water Well Record was completed on (mo/day/yr) 9-30-95 under the business name of Woofter Pump & Well, Inc. by (signature) Dale Woofter

INSTRUCTIONS: Use typewriter or ball point pen. PLEASE PRESS FIRMLY and PRINT clearly. Please fill in blanks, underline or circle the correct answers. Send top three copies to Kansas Department of Health and Environment, Bureau of Water, Topeka, Kansas 66620-0001. Telephone: 913-296-5545. Send one to WATER WELL OWNER and retain one for your records.