


WATER WELL RECORD Form WWC-5 KSA 82a-1212

1 LOCATION OF WATER WELL: Fraction C 1/4 NE 1/4 NW 1/4 Section Number 9 Township Number T 8 S Range Number R 28 EW
 County: Sheridan
 Distance and direction from nearest town or city street address of well if located within city?

2 WATER WELL OWNER: Sue Farmer
 RR#, St. Address, Box #: Board of Agriculture, Division of Water Resources
 City, State, ZIP Code: Box 603, Hoxie, KS 67740 Application Number: 1390&11195

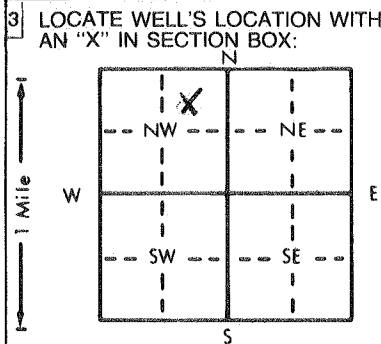

4 DEPTH OF COMPLETED WELL: 233 ft. ELEVATION:
 Depth(s) Groundwater Encountered 1 ft. 2 ft. 3 ft.
 WELL'S STATIC WATER LEVEL: 147 ft. below land surface measured on mo/day/yr
 Pump test data: Well water was ft. after hours pumping gpm
 Est. Yield gpm: Well water was ft. after hours pumping gpm
 Bore Hole Diameter: 24 in. to 233 ft., and in. to ft.
 WELL WATER TO BE USED AS:
 1 Domestic 3 Feedlot 6 Oil field water supply 9 Dewatering 12 Other (Specify below)
 2 Irrigation 4 Industrial 7 Lawn and garden only 10 Monitoring well
 Was a chemical/bacteriological sample submitted to Department? Yes No X; If yes, mo/day/yr sample was submitted
 Water Well Disinfected? Yes No X

5 TYPE OF BLANK CASING USED:
 1 Steel 3 RMP (SR) 5 Wrought iron 8 Concrete tile CASING JOINTS: Glued X Clamped
 2 PVC 4 ABS 6 Asbestos-Cement 9 Other (specify below) Welded
 7 Fiberglass Threaded
 Blank casing diameter 16 in. to 173 ft., Dia in. to ft., Dia in. to ft.
 Casing height above land surface 24 in., weight 16.15 lbs./ft. Wall thickness or gauge No. 500
 TYPE OF SCREEN OR PERFORATION MATERIAL:
 1 Steel 3 Stainless steel 5 Fiberglass 7 PVC 10 Asbestos-cement
 2 Brass 4 Galvanized steel 6 Concrete tile 8 RMP (SR) 11 Other (specify)
 12 None used (open hole)
 SCREEN OR PERFORATION OPENINGS ARE:
 1 Continuous slot 3 Mill slot 5 Gauzed wrapped 8 Saw cut 11 None (open hole)
 2 Louvered shutter 4 Key punched 6 Wire wrapped 9 Drilled holes
 7 Torch cut 10 Other (specify)
 SCREEN-PERFORATED INTERVALS: From 173 ft. to 233 ft., From ft. to ft.
 GRAVEL PACK INTERVALS: From 20 ft. to 233 ft., From ft. to ft.

6 GROUT MATERIAL: 1 Neat cement 2 Cement grout 3 Bentonite 4 Other
 Grout Intervals: From 0 ft. to 20 ft., From ft. to ft., From ft. to ft.
 What is the nearest source of possible contamination:
 1 Septic tank 4 Lateral lines 7 Pit privy 10 Livestock pens 14 Abandoned water well
 2 Sewer lines 5 Cess pool 8 Sewage lagoon 11 Fuel storage 15 Oil well/Gas well
 3 Watertight sewer lines 6 Seepage pit 9 Feedyard 12 Fertilizer storage 16 Other (specify below)
 13 Insecticide storage Plugged
 Direction from well? How many feet?

FROM	TO	LITHOLOGIC LOG	FROM	TO	PLUGGING INTERVALS
0	2	Surface	160	171	Tight Fine to Med. Sand w/a
2	20	Loess			Few Clay Layers
20	49	Clay & Caliche w/Sand Strks.	171	180	Fine to Med. Sand w/Clay Lyr
49	50	Caliche	180	195	Tight Med. Sand w/Clay &
50	55	Cemented Sand w/Clay			Loose Med. Sand Strks.
55	80	Med. Sand & Gravel w/a Few Clay Layers	195	203	Med. Sand & Gravel w/a Few
80	95	Sandy Clay w/Caliche	203	213	Cemented Sand w/Clay & a Few
95	103	Sandy Clay w/Sand Strks.			Sand Strks.
103	125	Cemented Sand w/Clay & Caliche Strks.	213	227	Med. Sand w/Clay & a Few
125	140	Tight Med. Sand w/Clay	227	233	Sand Strks.
140	153	Cemented Sand			Shale
153	160	Cemented Sand w/Clay & a Few Sand Strks.			

7 CONTRACTOR'S OR LANDOWNER'S CERTIFICATION: This water well was (1) constructed, (2) reconstructed, or (3) plugged under my jurisdiction and was completed on (mo/day/year) 3-7-97 and this record is true to the best of my knowledge and belief. Kansas Water Well Contractor's License No. 554 This Water Well Record was completed on (mo/day/yr) 3-12-97 under the business name of Woofter Pump & Well, Inc. by (signature) Jayle Woofter

INSTRUCTIONS: Use typewriter or ball point pen. PLEASE PRESS FIRMLY and PRINT clearly. Please fill in blanks, underline or circle the correct answers. Send top three copies to Kansas Department of Health and Environment, Bureau of Water, Topeka, Kansas 66620-0001. Telephone: 913-296-5545. Send one to WATER WELL OWNER and retain one for your records.