


WATER WELL RECORD Form WWC-5 KSA 82a-1212

1 LOCATION OF WATER WELL: Fraction C $\frac{1}{4}$ SW $\frac{1}{4}$ SE $\frac{1}{4}$ Section Number 16 Township Number T 8 S Range Number R 28 EW

Distance and direction from nearest town or city street address of well if located within city?

2 WATER WELL OWNER: Gene Deines
 RR#, St. Address, Box # : 416 Sheridan Board of Agriculture, Division of Water Resources
 City, State, ZIP Code : Hoxie, KS 67740 Application Number:

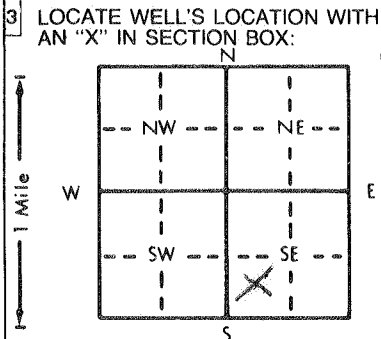

4 DEPTH OF COMPLETED WELL... 170 ft. ELEVATION:ft.
 Depth(s) Groundwater Encountered 1.ft. 2.ft. 3.ft.
 WELL'S STATIC WATER LEVEL ... 84 ft. below land surface measured on mo/day/yrft.
 Pump test data: Well water wasft. after hours pumping gpm
 Est. Yield gpm: Well water wasft. after hours pumping gpm
 Bore Hole Diameter... 8 in. to 170 ft., and in. toft.
 WELL WATER TO BE USED AS: 5 Public water supply 8 Air conditioning 11 Injection well
 1 Domestic 3 Feedlot 6 Oil field water supply 9 Dewatering 12 Other (Specify below)
 2 Irrigation 4 Industrial 7 Lawn and garden only 10 Monitoring well
 Was a chemical/bacteriological sample submitted to Department? Yes.....No X; If yes, mo/day/yr sample was submitted
 Water Well Disinfected? Yes No X

5 TYPE OF BLANK CASING USED: 5 Wrought iron 8 Concrete tile CASING JOINTS: Glued X Clamped
 1 Steel 3 RMP (SR) 6 Asbestos-Cement 9 Other (specify below) Welded
 2 PVC 4 ABS 7 Fiberglass Threaded.....
 Blank casing diameter 4.5 in. to 130 ft., Diain. toft., Diain. toft.
 Casing height above land surface 18 in, weight 2.38 lbs./ft. Wall thickness or gauge No. 248
 TYPE OF SCREEN OR PERFORATION MATERIAL: 7 PVC 10 Asbestos-cement
 1 Steel 3 Stainless steel 5 Fiberglass 8 RMP (SR) 11 Other (specify)
 2 Brass 4 Galvanized steel 6 Concrete tile 9 ABS 12 None used (open hole)
 SCREEN OR PERFORATION OPENINGS ARE: 5 Gauzed wrapped 8 Saw cut 11 None (open hole)
 1 Continuous slot 3 Mill slot 6 Wire wrapped 9 Drilled holes
 2 Louvered shutter 4 Key punched 7 Torch cut 10 Other (specify)
 SCREEN-PERFORATED INTERVALS: From 130 ft. to 170 ft., Fromft. toft.
 Fromft. toft., Fromft. toft.
 GRAVEL PACK INTERVALS: From 20 ft. to 170 ft., Fromft. toft.
 Fromft. toft., Fromft. toft.

6 GROUT MATERIAL: 1 Neat cement 2 Cement grout 3 Bentonite 4 Other
 Grout Intervals: From 0 ft. to 20 ft., Fromft. toft., Fromft. toft.
 What is the nearest source of possible contamination:
 1 Septic tank 4 Lateral lines 7 Pit privy 10 Livestock pens 14 Abandoned water well
 2 Sewer lines 5 Cess pool 8 Sewage lagoon 11 Fuel storage 15 Oil well/Gas well
 3 Watertight sewer lines 6 Seepage pit 9 Feedyard 12 Fertilizer storage 16 Other (specify below)
 13 Insecticide storage
 Direction from well? How many feet?

FROM	TO	LITHOLOGIC LOG	FROM	TO	PLUGGING INTERVALS
0	2	Surface			
2	16	Loess			
16	32	Sandy Clay w/Fine Sand			
32	64	Med. Sand & Gravel w/Clay			
64	71	Caliche, Cemented Sand & Clay w/Some Sand			
71	87	Med. Sand & Gravel			
87	100	Sandy Clay & Caliche w/some Med Sand Strks.			
100	113	Med. Sand & Gravel w/Clay Strks.			
113	116	Cemented Sand w/Clay			
116	120	Med. Sand & Gravel w/Clay & Cem. Strks.			
120	160	Med. Sand w/Clay & Caliche Strks.			
160	165	Med. Sand & Gravel			
165	170	Ochre & Shale			

7 CONTRACTOR'S OR LANDOWNER'S CERTIFICATION: This water well was (1) constructed, (2) reconstructed, or (3) plugged under my jurisdiction and was completed on (mo/day/year) 5-2-98 and this record is true to the best of my knowledge and belief. Kansas Water Well Contractor's License No. 554 This Water Well Record was completed on (mo/day/yr) 5-14-98 under the business name of Woofter Pump & Well, Inc. by (signature) Jay C. Woofter

INSTRUCTIONS: Use typewriter or ball point pen. PLEASE PRESS FIRMLY and PRINT clearly. Please fill in blanks, underline or circle the correct answers. Send top three copies to Kansas Department of Health and Environment, Bureau of Water, Topeka, Kansas 66620-0001. Telephone: 913-296-5545. Send one to WATER WELL OWNER and retain one for your records.