

WATER WELL PLUGGING RECORD Form WWC-5P

KSA 82a-1212 ID NO.


MW-1

1 LOCATION OF WATER WELL: Fraction SW ¼ SW¼ SW ¼ NW ¼ Section Number 15 Township Number T 8 S Range Number 28 E W
 County: Sheridan

Street/Rural Address of Well Location; if unknown, distance & direction from nearest town or intersection: If at owner's address, check here

Global Positioning Systems (GPS) information:
 Latitude: _____ (in decimal degrees)
 Longitude: _____ (in decimal degrees)
 Elevation: _____
 Horizontal Datum: WGS84, NAD83, NAD27
 Collection Method:
 GPS unit (Make/Model): _____
 Digital Map/Photo, Topographic Map, Land Survey
 Est. Accuracy: < 3 m, 3-5 m, 5-15 m, > 15 m

2 WATER WELL OWNER: Gene Deines, Stop 2 Shop
 RR#, St. Address, Box #: 1017 Oak Avenue
 City, State ZIP Code: Hoxie, KS 67740

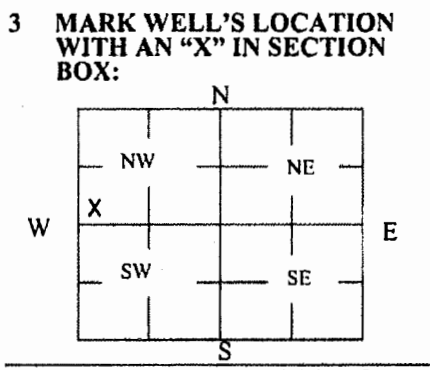

4 DEPTH OF WELL 120.00 ft.
WELL'S STATIC WATER LEVEL 109.15 ft
WELL WAS USED AS:
 Domestic Public Water Supply Dewatering
 Irrigation Oil Field Water Supply Monitoring **MW-1**
 Feedlot Domestic (Lawn & Garden) Injection Well
 Industrial Air Conditioning Other _____
 Was a chemical/bacteriological sample submitted to Department? Yes No


5 TYPE OF BLANK CASING USED:
 Steel RMP (SR) Wrought Fiberglass Other (Specify below)
 PVC ABS Asbestos-Cement Concrete Tile
 Blank casing diameter 4 in. Was casing pulled? Yes No If yes, how much 3'
 Casing height above or below land surface -36 in.

6 GROUT PLUG MATERIAL: Neat cement Cement grout Bentonite Other concrete 0-1'
 Grout Plug Intervals: From 3 ft. to 120.00 ft., From _____ ft. to _____ ft., From _____ ft. to _____ ft.
 What is the nearest source of possible contamination:
 Septic tank Seepage pit Fuel storage Other (specify below)
 Sewer lines Pit privy Fertilizer storage
 Watertight sewer lines Sewage lagoon Insecticide storage
 Lateral lines Feedyard Abandoned water well Direction from well? _____
 Cess pool Livestock pens Oil well/Gas well How many feet? _____

FROM	TO	PLUGGING MATERIALS	FROM	TO	PLUGGING MATERIALS
0	1	Concrete			Notes:
1	3	Native Soil			Hoxie Stop 2 Shop
3	120	Bentonite Grout			KDHE/BER project code:U6-090-14793

7 CONTRACTOR'S OR LANDOWNER'S CERTIFICATION: This water well was plugged under my jurisdiction and was completed on (mo/day/year) 8/10/17 and this record is true to the best of my knowledge and belief. Kansas Water Well Contractor's License No. 735. This Water Well Record was completed on (mo/day/year) 8/23/17 under the business name of MILCO Environmental Services by (signature) *[Signature]*

Send one white copy to Kansas Department of Health & Environment, Geology Section, 1000 SW Jackson Street, Ste. 420, Topeka, KS 66612-1367. Send one copy to WATER WELL OWNER and retain one for your records.
 Visit us at <http://www.kdheks.gov/waterwell/index.html> Telephone 785-296-5524.

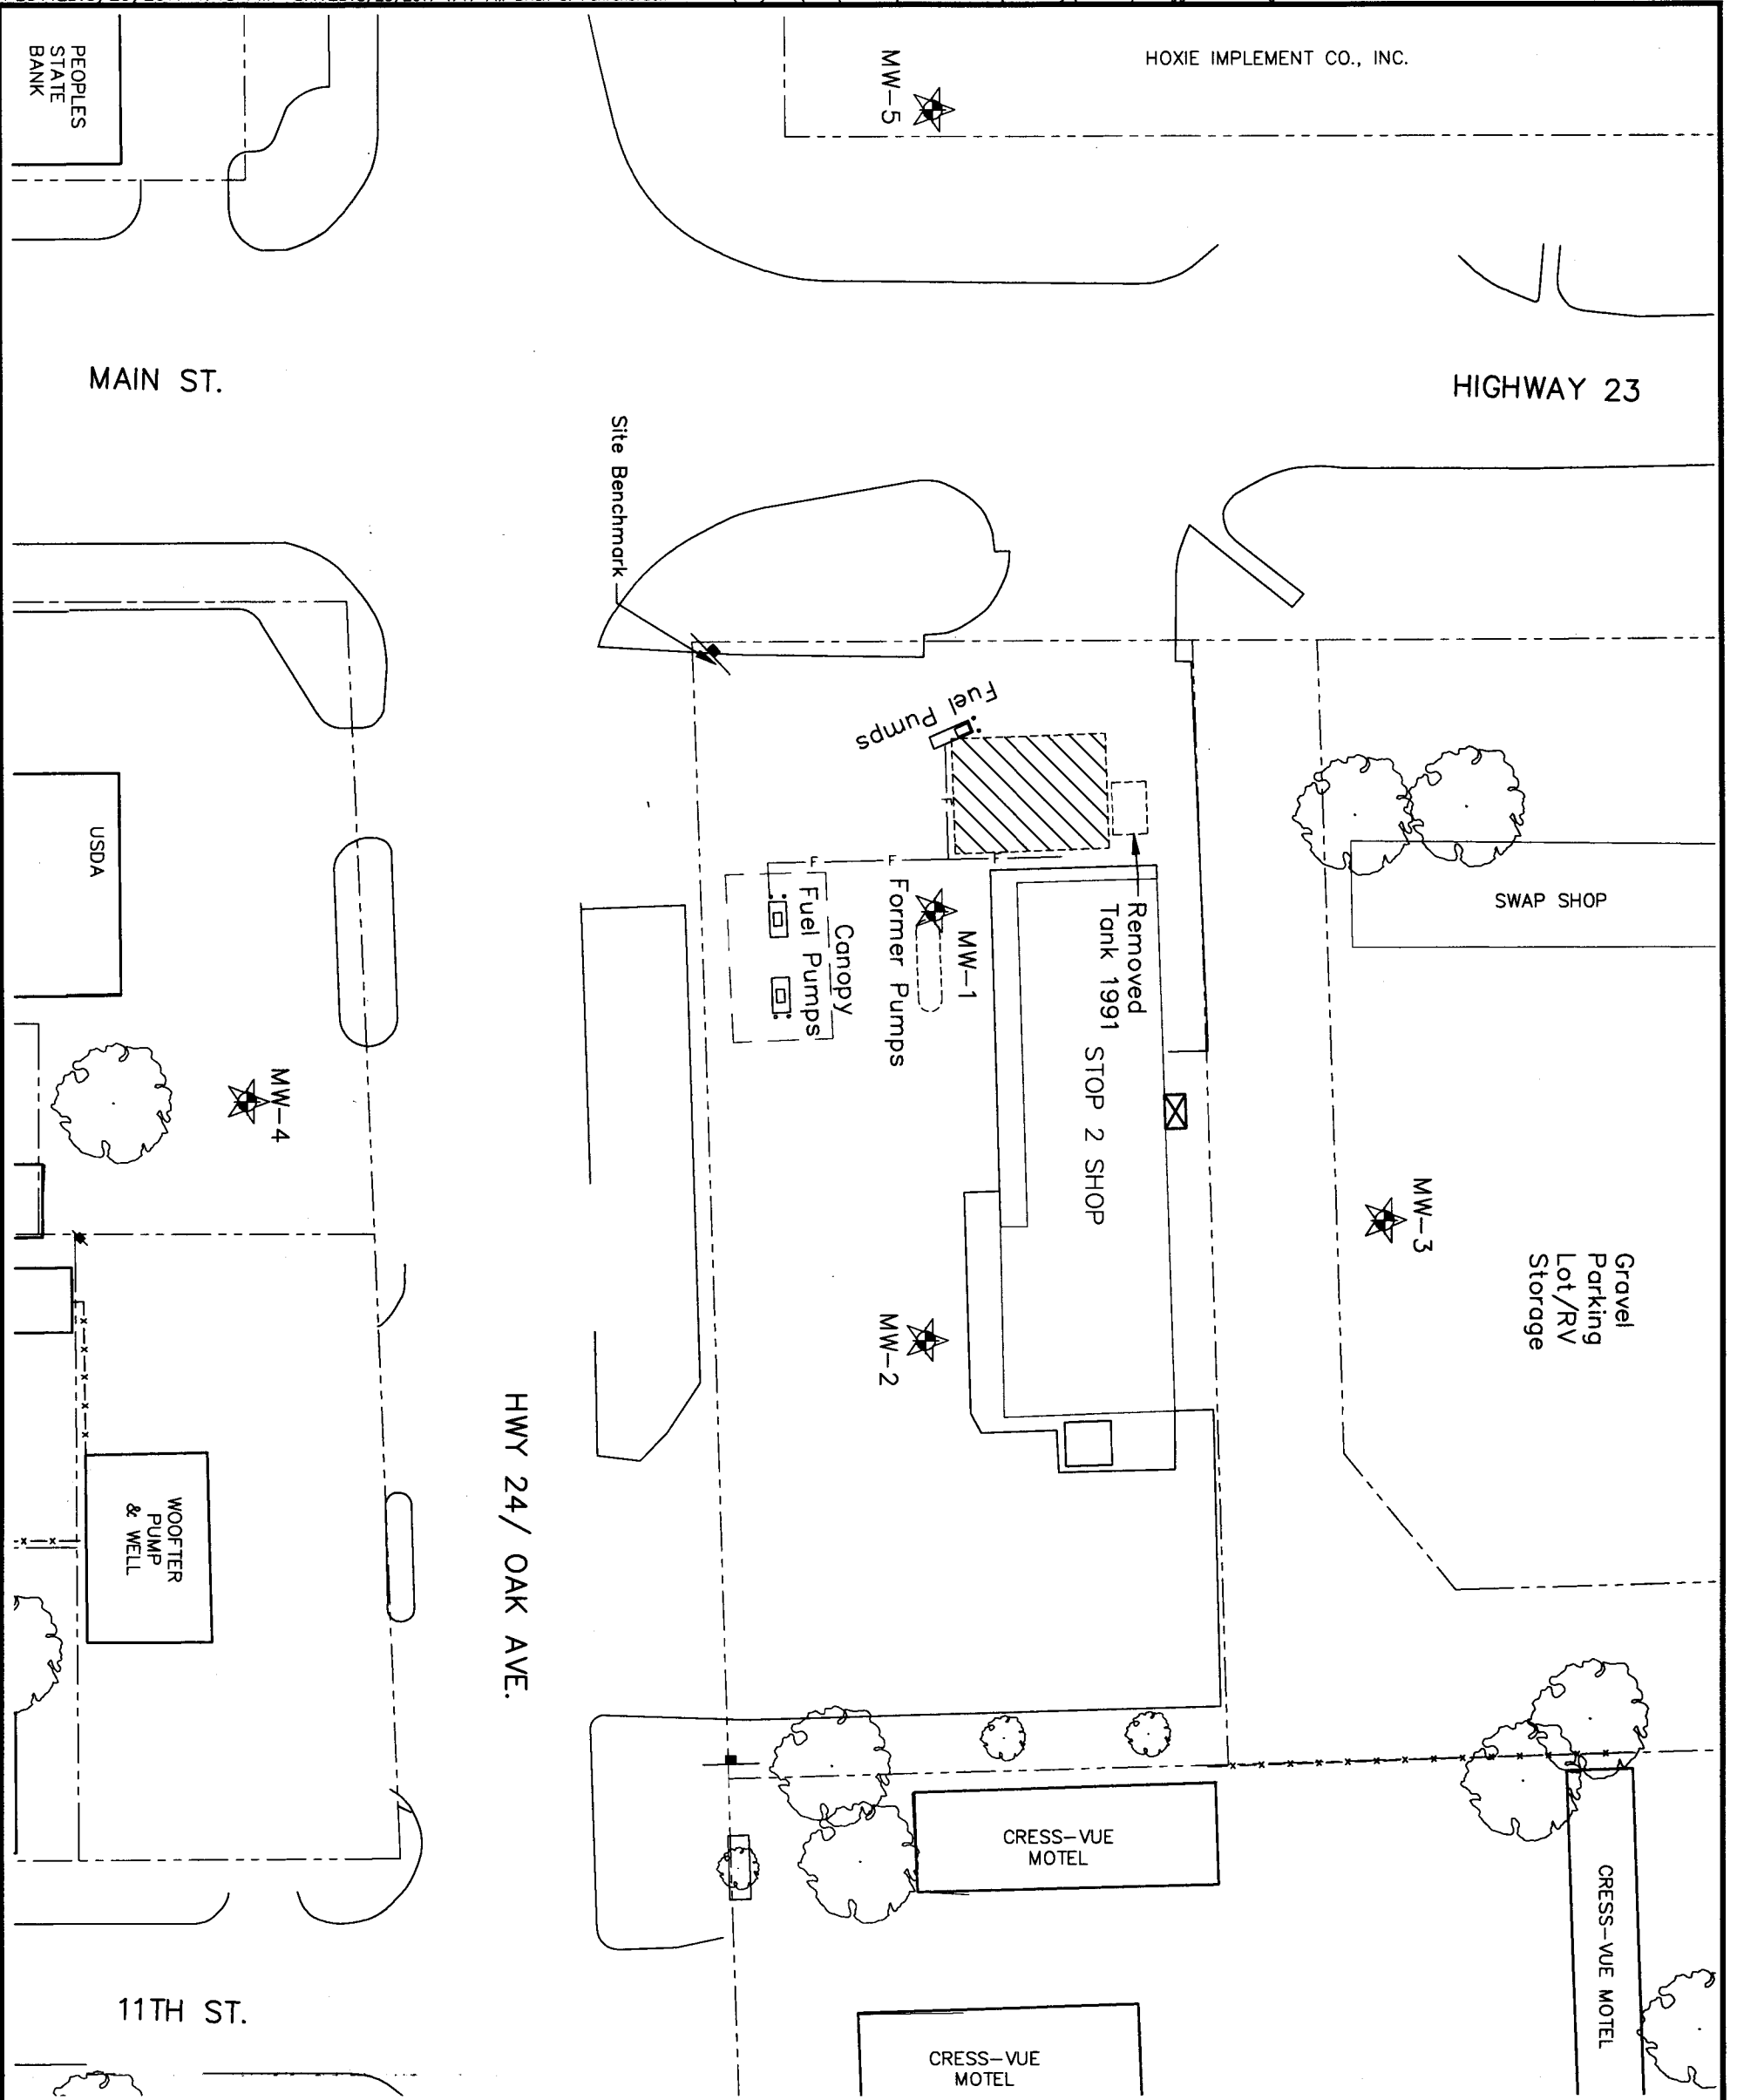

LEGEND

- = PLUGGED WELL
- = PRODUCT LINES
- = UST BASIN
- = COMMERCIAL SIGN
- = APPROXIMATE ROW LINES/ PROPERTY LINES

SITE BENCHMARK:
 CHISLED 'X' ON TOP OF EASTERLY BASE
 BOLT OF NORTHEASTERLY LEG OF GAS
 PRICE SIGN IN SW CORNER OF PROPERTY.
 ELEV. = 2715.25

NOTE:
 WELLS ABANDONED ON
 AUGUST 10, 2017

0 20 40 80
 SCALE IN FEET

<p>REVISIONS</p> <p>BY</p>	<p>MILCO Environmental Services, Inc.</p> <p>Kearney, NE (308) 237-9923 McCook, NE (308) 545-4741 O'neill, NE (402) 450-1955</p>	<p>HOXIE STOP 2 SHOP SITE BASE MAP 1017 OAK AVE., HOXIE KANSAS U6-090-14793</p>	<p>SCALE: AS SHOWN</p> <p>PROJECT NO. M259-P8-01</p> <p>DATE: AUGUST, 2017</p> <p>FIELD BOOK: M&A DMC NO.</p> <p>DRAWN BY: APRVD BY:</p> <p>SHEET</p> <p>FIGURE 1</p>
----------------------------	---	---	--