

WATER WELL PLUGGING RECORD Form WWC-5P

KSA 82a-1212

ID NO.


MW-3

1 **LOCATION OF WATER WELL:** Fraction SW 1/4 SW 1/4 SW 1/4 NW 1/4 Section Number 15 Township Number T 8 S Range Number 28 E W
 County: Sheridan

Street/Rural Address of Well Location; if unknown, distance & direction from nearest town or intersection: If at owner's address, check here

Global Positioning Systems (GPS) information:
 Latitude: _____ (in decimal degrees)
 Longitude: _____ (in decimal degrees)
 Elevation: _____
 Horizontal Datum: WGS84, NAD83, NAD27
 Collection Method: _____
 GPS unit (Make/Model: _____)
 Digital Map/Photo, Topographic Map, Land Survey
 Est. Accuracy: < 3 m, 3-5 m, 5-15 m, > 15 m

2 **WATER WELL OWNER:** Hoxie Stop 2 Shop
 RR#, St. Address, Box #: 1017 Oak Avenue
 City, State ZIP Code: Hoxie, KS 67740

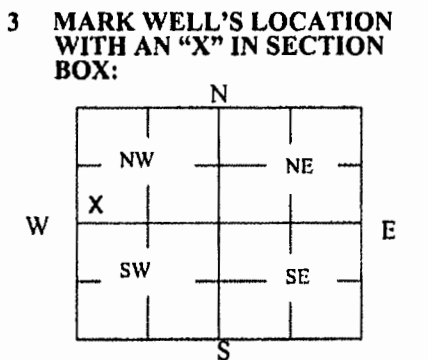

4 **DEPTH OF WELL** 129.20 ft.
WELL'S STATIC WATER LEVEL 108.18 ft.
WELL WAS USED AS:
 Domestic Public Water Supply Dewatering
 Irrigation Oil Field Water Supply Monitoring **MW-3**
 Feedlot Domestic (Lawn & Garden) Injection Well
 Industrial Air Conditioning Other _____
 Was a chemical/bacteriological sample submitted to Department? Yes No


5 **TYPE OF BLANK CASING USED:**
 Steel RMP (SR) Wrought Fiberglass Other (Specify below) _____
 PVC ABS Asbestos-Cement Concrete Tile
 Blank casing diameter 4 in. Was casing pulled? Yes No If yes, how much 3'
 Casing height above or below land surface -36 in.

6 **GROUT PLUG MATERIAL:** Neat cement Cement grout Bentonite Other _____
 Grout Plug Intervals: From 3 ft. to 129.2 ft., From _____ ft. to _____ ft., From _____ ft. to _____ ft.
 What is the nearest source of possible contamination:
 Septic tank Sepage pit Fuel storage Other (specify below) _____
 Sewer lines Pit privy Fertilizer storage
 Watertight sewer lines Sewage lagoon Insecticide storage
 Lateral lines Feedyard Abandoned water well Direction from well? _____
 Cess pool Livestock pens Oil well/Gas well How many feet? _____

| FROM | TO | PLUGGING MATERIALS | FROM | TO | PLUGGING MATERIALS |
|------|-------|--------------------|------|----|------------------------------------|
| 0 | 3 | Native Soil | | | Notes: |
| 3 | 129.2 | Bentonite Grout | | | Hoxie Stop 2 Shop, 1017 Oak Avenue |
| | | | | | KDHE/BER project code:U6-090-14793 |
| | | | | | |
| | | | | | |
| | | | | | |

7 **CONTRACTOR'S OR LANDOWNER'S CERTIFICATION:** This water well was plugged under my jurisdiction and was completed on (mo/day/year) 8/10/17 and this record is true to the best of my knowledge and belief. Kansas Water Well Contractor's License No. 735. This Water Well Record was completed on (mo/day/year) 8/23/17 under the business name of MILCO Environmental Services, Inc. by (signature) *[Signature]*

Send one white copy to Kansas Department of Health & Environment, Geology Section, 1000 SW Jackson Street, Ste. 420, Topeka, KS 66612-1367. Send one copy to WATER WELL OWNER and retain one for your records.
 Visit us at <http://www.kdheks.gov/waterwell/index.html> Telephone 785-296-5524.

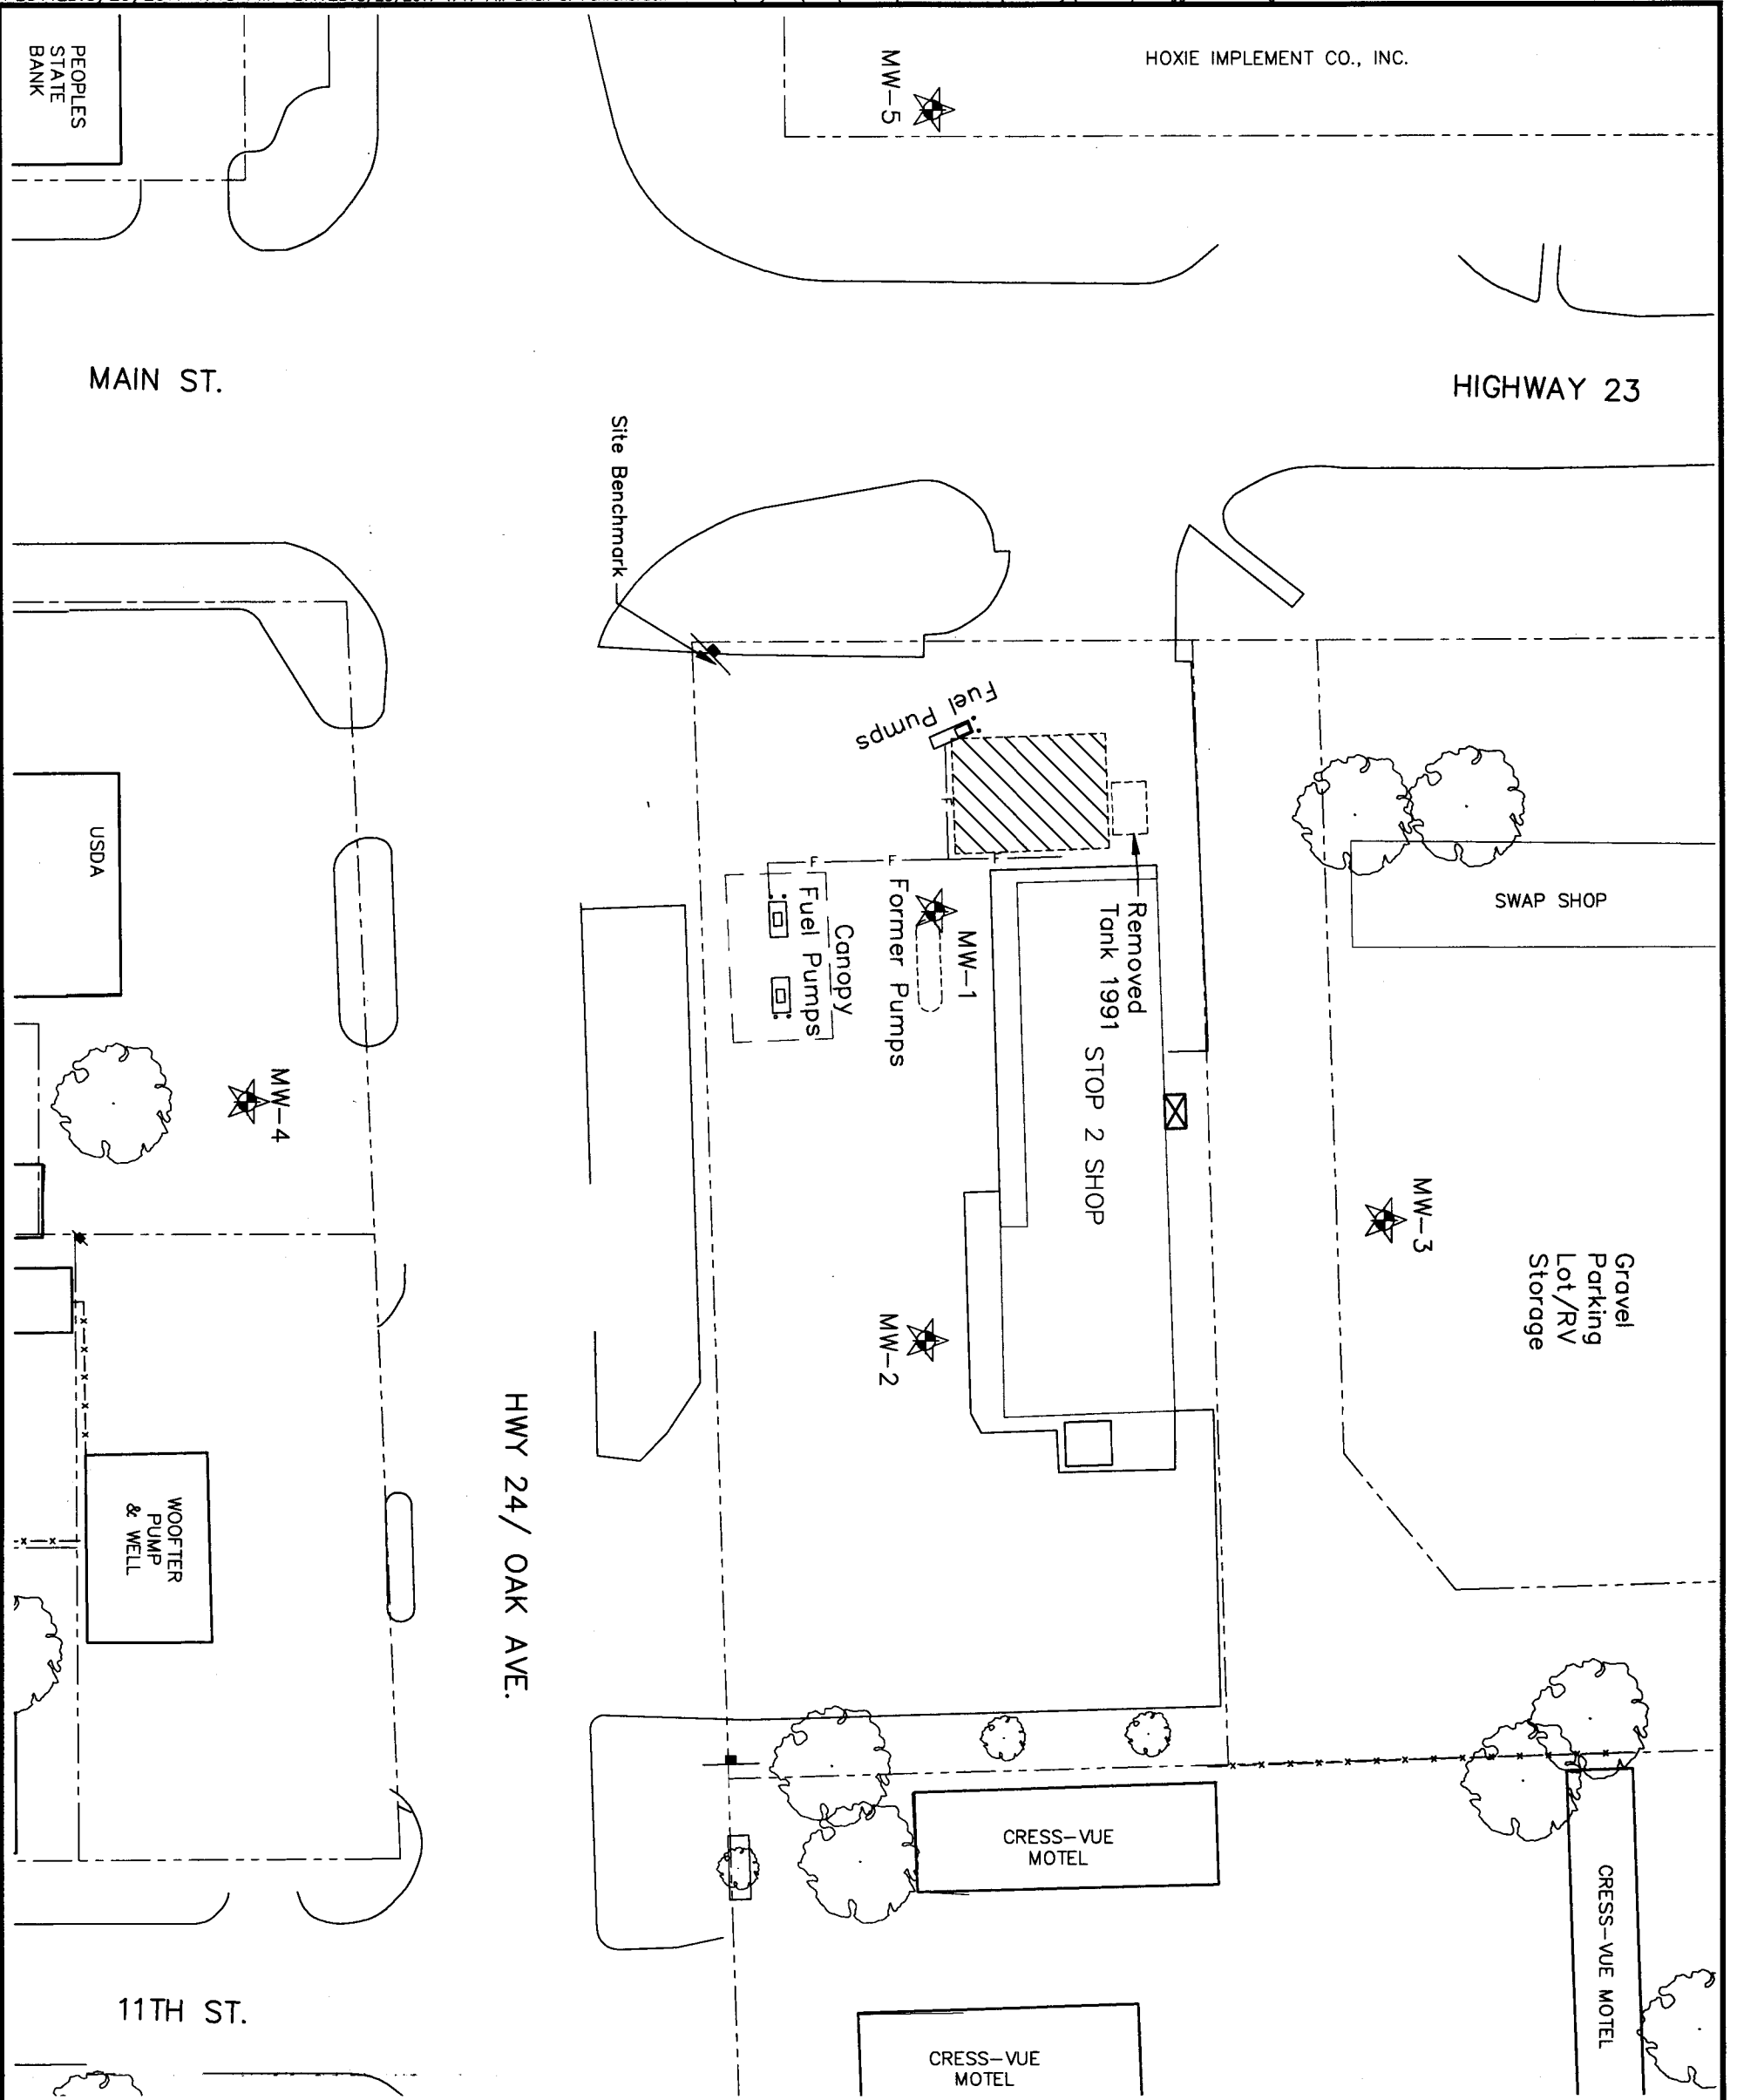


LEGEND

- = PLUGGED WELL
- = PRODUCT LINES
- = UST BASIN
- = COMMERCIAL SIGN
- = APPROXIMATE ROW LINES/ PROPERTY LINES

SITE BENCHMARK:
 CHISLED 'X' ON TOP OF EASTERLY BASE
 BOLT OF NORTHEASTERLY LEG OF GAS
 PRICE SIGN IN SW CORNER OF PROPERTY.
 ELEV. = 2715.25

NOTE:
 WELLS ABANDONED ON
 AUGUST 10, 2017

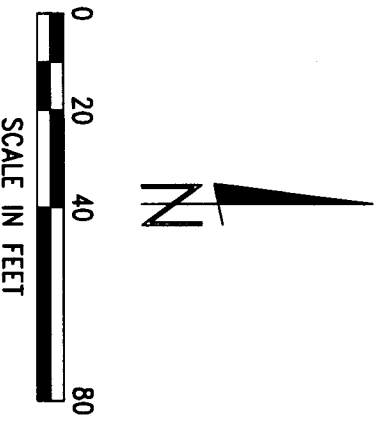

| | | | |
|----------------------------|---|---|--|
| <p>REVISIONS</p> <p>BY</p> | <p>MILCO Environmental Services, Inc.</p> <p>Kearney, NE (308) 237-9923 McCook, NE (308) 545-4741 O'neill, NE (402) 450-1955</p> | <p>HOXIE STOP 2 SHOP SITE BASE MAP 1017 OAK AVE., HOXIE KANSAS U6-090-14793</p> | <p>SCALE: AS SHOWN</p> <p>PROJECT NO. M259-P8-01</p> <p>DATE: AUGUST, 2017</p> <p>FIELD BOOK: M&A DMC NO.</p> <p>DRAWN BY: APRVD BY:</p> <p>SHEET</p> <p>FIGURE 1</p> |
|----------------------------|---|---|--|