

**WATER WELL PLUGGING RECORD Form WWC-5P**

KSA 82a-1212

ID NO.

MW-5


1 **LOCATION OF WATER WELL:** Fraction SE 1/4 SE 1/4 SE 1/4 NE 1/4 Section Number 16 Township Number T 8 S Range Number 28  E  W  
 County: Sheridan

Street/Rural Address of Well Location; if unknown, distance & direction from nearest town or intersection: If at owner's address, check here  933 Oak Avenue, Hoxie

**Global Positioning Systems (GPS) information:**  
 Latitude: \_\_\_\_\_ (in decimal degrees)  
 Longitude: \_\_\_\_\_ (in decimal degrees)  
 Elevation: \_\_\_\_\_  
 Horizontal Datum:  WGS84,  NAD83,  NAD27  
 Collection Method:  
 GPS unit (Make/Model: \_\_\_\_\_)  
 Digital Map/Photo,  Topographic Map,  Land Survey  
 Est. Accuracy:  < 3 m,  3-5 m,  5-15 m,  > 15 m

2 **WATER WELL OWNER:** Gene Deines, Stop 2 Shop RR#, St. Address, Box #: 1017 Oak Avenue  
 City, State ZIP Code: Hoxie, KS 67740

3 **MARK WELL'S LOCATION WITH AN "X" IN SECTION BOX:**

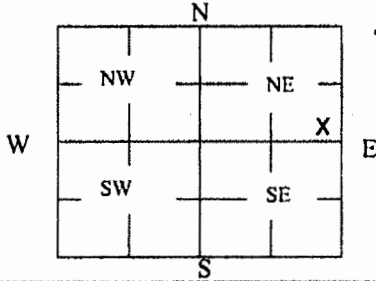

4 **DEPTH OF WELL** 129.7 ft.  
**WELL'S STATIC WATER LEVEL** 109.57 ft.  
**WELL WAS USED AS:**

- Domestic
- Irrigation
- Feedlot
- Industrial
- Public Water Supply
- Oil Field Water Supply
- Domestic (Lawn & Garden)
- Air Conditioning
- Dewatering
- Monitoring **MW-5**
- Injection Well
- Other \_\_\_\_\_

Was a chemical/bacteriological sample submitted to Department? Yes  No

5 **TYPE OF BLANK CASING USED:**

- Steel
- RMP (SR)
- Wrought
- Fiberglass
- Other (Specify below) \_\_\_\_\_
- PVC
- ABS
- Asbestos-Cement
- Concrete Tile

Blank casing diameter 4 in. Was casing pulled? Yes  No  If yes, how much 3'  
 Casing height above or below land surface -36 in.

6 **GROUT PLUG MATERIAL:**  Neat cement  Cement grout  Bentonite  Other \_\_\_\_\_

Grout Plug Intervals: From 3 ft. to 129.7 ft., From \_\_\_\_\_ ft. to \_\_\_\_\_ ft., From \_\_\_\_\_ ft. to \_\_\_\_\_ ft.


What is the nearest source of possible contamination:

- Septic tank
  - Sewer lines
  - Watertight sewer lines
  - Lateral lines
  - Cess pool
  - Seepage pit
  - Pit privy
  - Sewage lagoon
  - Feedyard
  - Livestock pens
  - Fuel storage
  - Fertilizer storage
  - Insecticide storage
  - Abandoned water well
  - Oil well/Gas well
  - Other (specify below) \_\_\_\_\_
- Direction from well? \_\_\_\_\_  
 How many feet? \_\_\_\_\_

FROM	TO	PLUGGING MATERIALS	FROM	TO	PLUGGING MATERIALS
0	3	Native Soil			Notes:
3	129.7	Bentonite Grout			Hoxie Stop 2 Shop, 1017 Oak Avenue
					KDHE/BER project code:U6-090-14793

7 **CONTRACTOR'S OR LANDOWNER'S CERTIFICATION:** This water well was plugged under my jurisdiction and was completed on (mo/day/year) 8/10/17 and this record is true to the best of my knowledge and belief. Kansas Water Well Contractor's License No. 735. This Water Well Record was completed on (mo/day/year) 8/23/17 under the business name of MILCO Environmental Services, Inc. by (signature) *[Signature]*

Send one white copy to Kansas Department of Health & Environment, Geology Section, 1000 SW Jackson Street, Ste. 420, Topeka, KS 66612-1367. Send one copy to WATER WELL OWNER and retain one for your records.  
 Visit us at <http://www.kdheks.gov/waterwell/index.html> Telephone 785-296-5524.

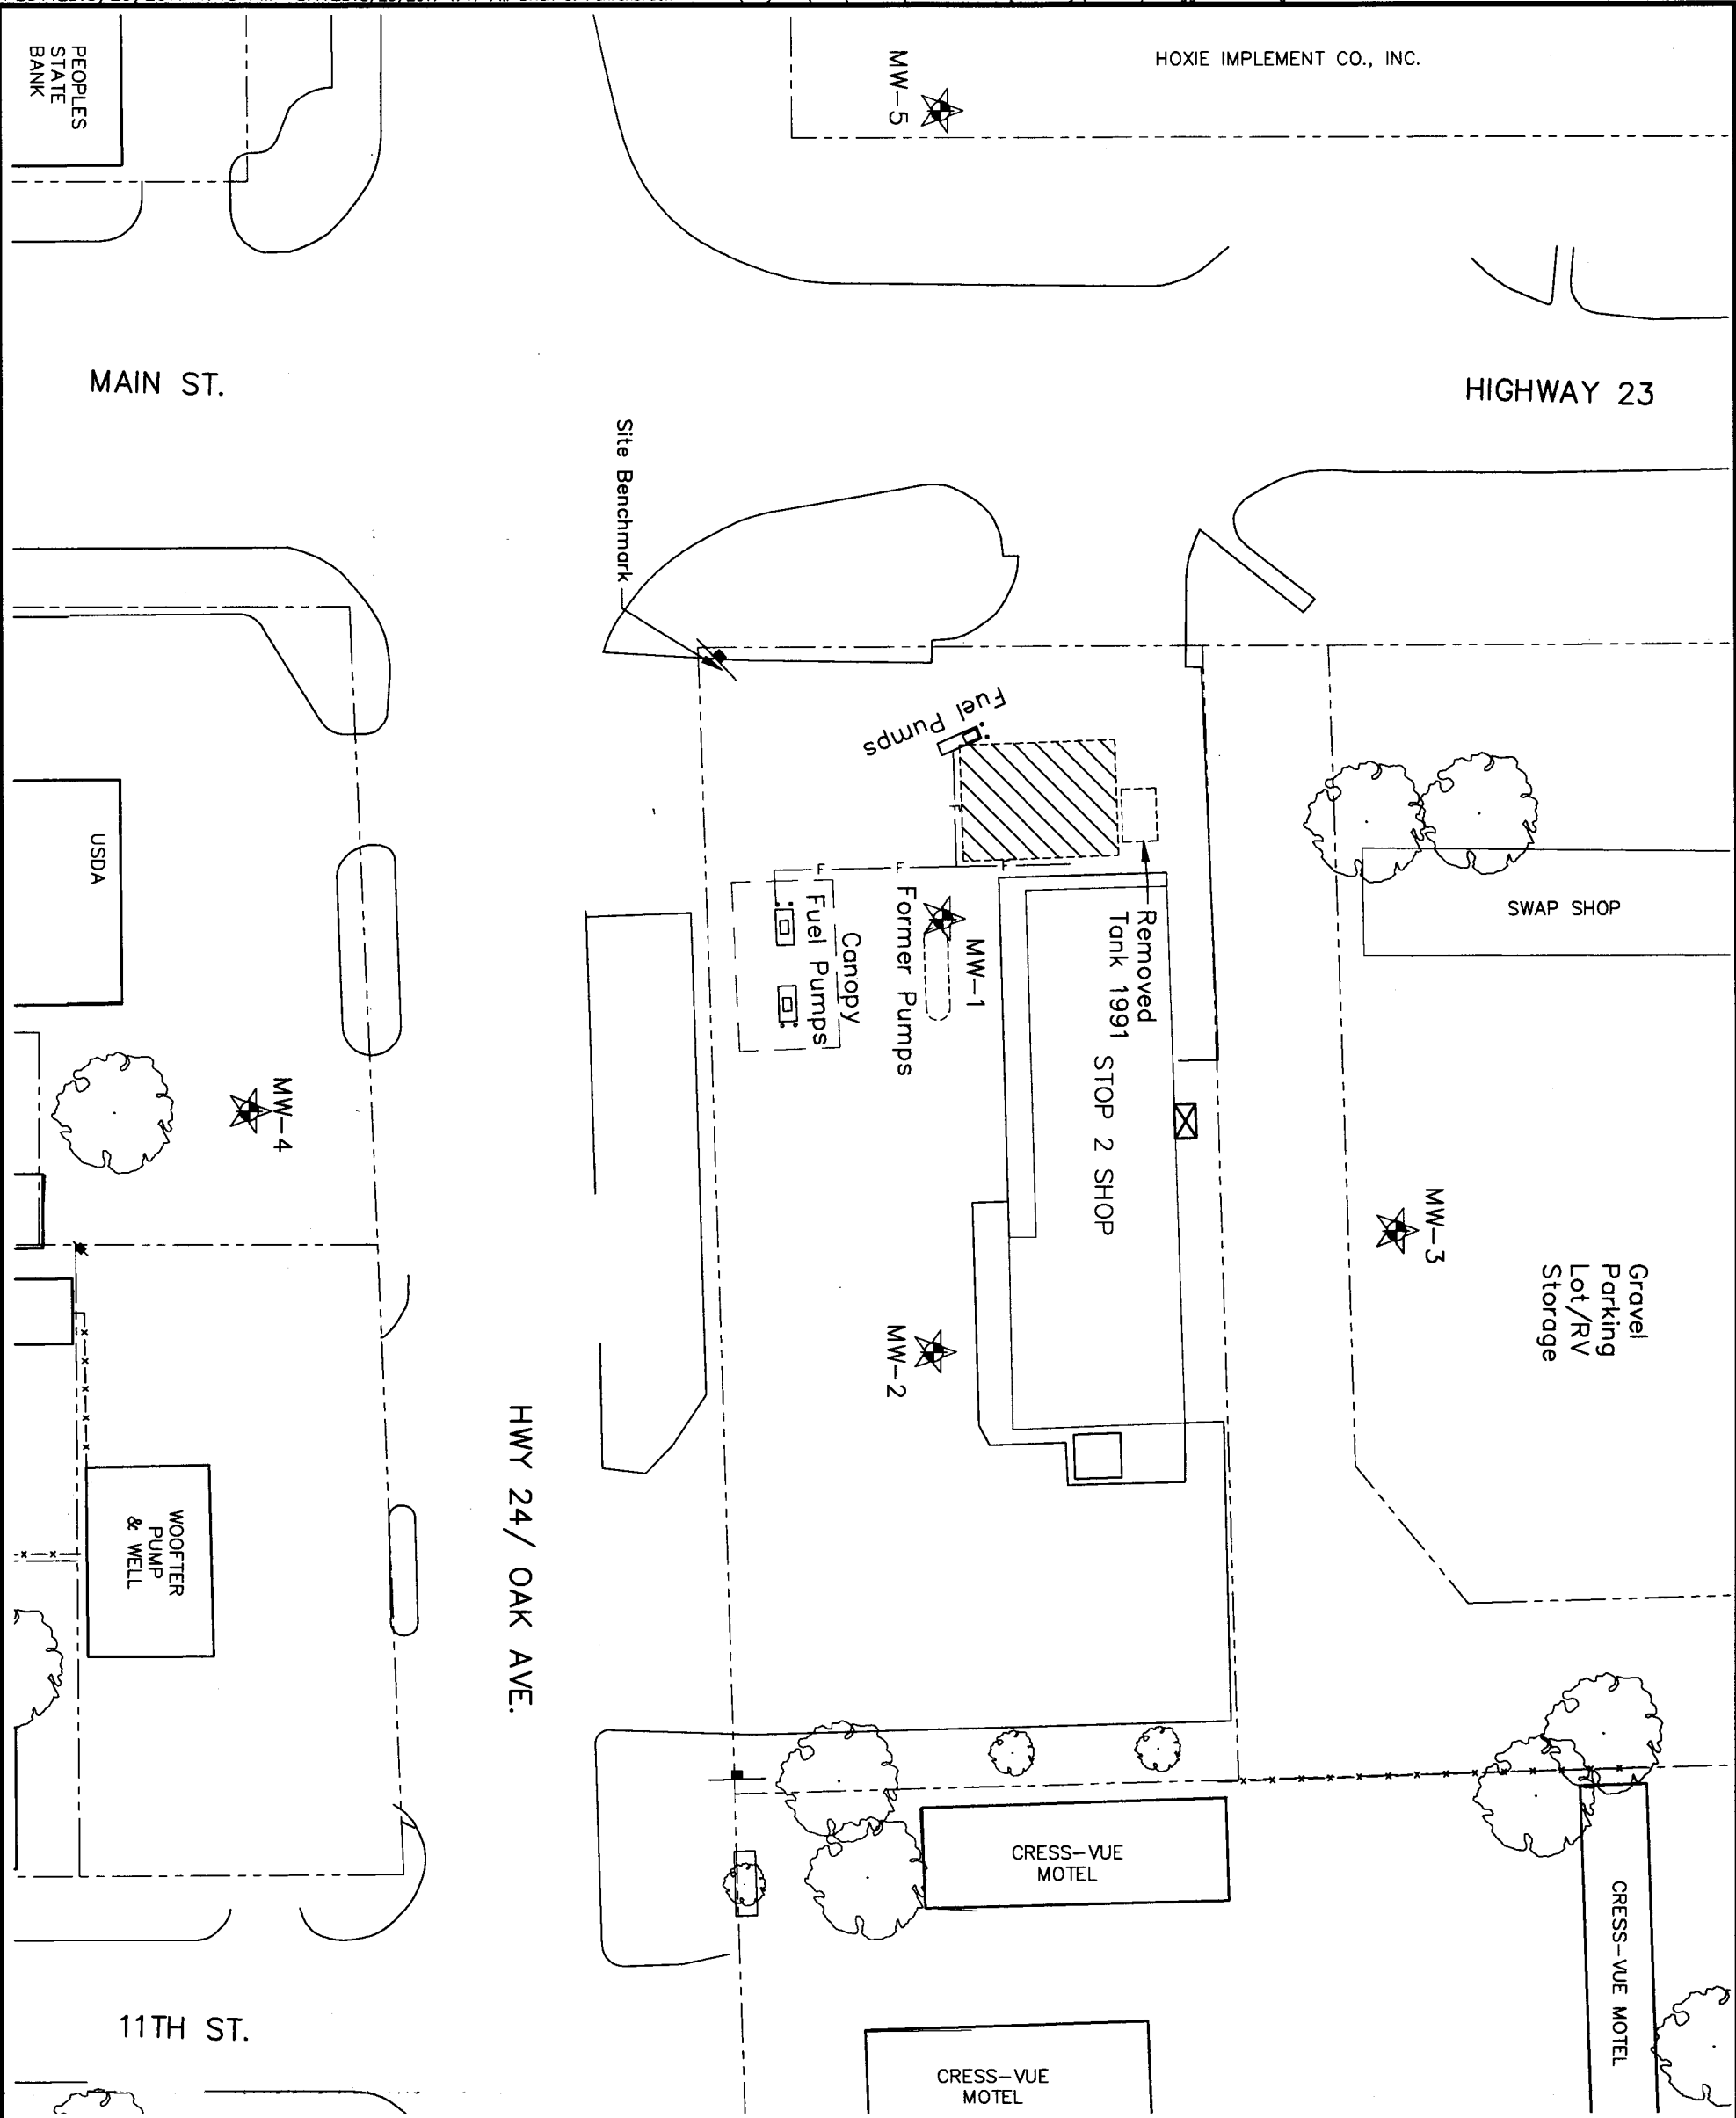

**LEGEND**

- = PLUGGED WELL
- = PRODUCT LINES
- = UST BASIN
- = COMMERCIAL SIGN
- = APPROXIMATE ROW LINES/PROPERTY LINES

**SITE BENCHMARK:**  
 CHISLED 'X' ON TOP OF EASTERLY BASE  
 BOLT OF NORTHEASTERLY LEG OF GAS  
 PRICE SIGN IN SW CORNER OF PROPERTY.  
 ELEV. = 2715.25

**NOTE:**  
 WELLS ABANDONED ON  
 AUGUST 10, 2017

SCALE IN FEET

<p>REVISIONS</p> <p>BY</p>	<p><b>MILCO</b>                  Environmental                  Services, Inc.</p> <p>Kearney, NE (308) 237-9923                  McCook, NE (308) 545-4741                  O'neill, NE (402) 450-1955</p>	<p><b>HOXIE STOP 2 SHOP</b>  <b>SITE BASE MAP</b>                  1017 OAK AVE., HOXIE KANSAS U6-090-14793</p>	<p>SCALE: AS SHOWN</p> <p>PROJECT NO. M259-P8-01</p> <p>DATE: AUGUST, 2017</p> <p>FIELD BOOK: M&amp;A DMC NO.</p> <p>DRAWN BY: APRVD BY:</p> <p>SHEET</p> <p><b>FIGURE 1</b></p>
----------------------------	---	---	--