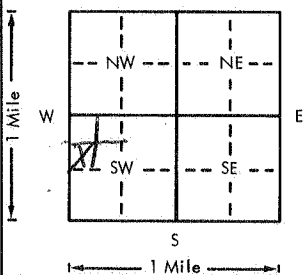


USE TYPEWRITER OR BALL POINT PEN-PRESS FIRMLY, PRINT CLEARLY.

WATER WELL RECORD
KSA 82a-1201-1215

Kansas Department of Health and Environment-Division of Environment
(Water well Contractors)
Topeka, Kansas 66620

CBC

1. Location of well: County <u>Sheridan</u> Fraction <u>SW 1/4 NW 1/4 SW 1/4</u> Section number <u>2</u> Township number <u>T 8 S R 28 E/W</u> Range number	
2. Distance and direction from nearest town or city: <u>1 E 2 1/2 N</u> Street address of well location if in city: <u>Hoxie Ks.</u> 3. Owner of well: <u>VERN MAURY</u> R.R. or street: <u>R.</u> City, state, zip code: <u>Hoxie Ks.</u>	
4. Locate with "X" in section below: Sketch map: 	
5. Type and color of material	
6. Bore hole dia. <u>9</u> in. Completion date <u>8-18-76</u> Well depth <u>192</u> ft.	
7. Cable tool <input checked="" type="checkbox"/> Rotary <input type="checkbox"/> Driven <input type="checkbox"/> Dug <input type="checkbox"/> Hollow rod <input type="checkbox"/> Jetted <input type="checkbox"/> Bored <input type="checkbox"/> Reverse rotary	
8. Use: <input checked="" type="checkbox"/> Domestic <input type="checkbox"/> Public supply <input type="checkbox"/> Industry <input type="checkbox"/> Irrigation <input type="checkbox"/> Air conditioning <input type="checkbox"/> Stock <input type="checkbox"/> Lawn <input type="checkbox"/> Oil field water <input type="checkbox"/> Other	
9. Casing: Material <input type="checkbox"/> Height: Above or below <input checked="" type="checkbox"/> Threaded <input type="checkbox"/> Welded <input type="checkbox"/> Surface <u>4'</u> in. RMP <input type="checkbox"/> PVC <input checked="" type="checkbox"/> Weight <input type="checkbox"/> lbs./ft. Dia. <u>5</u> in. to <u>192</u> ft. depth Wall thickness: inches or Dia. <input type="checkbox"/> in. to <input type="checkbox"/> ft. depth gage No. <u>200</u>	
10. Screen: Manufacturer's name <u>Less Lowell</u> Type <u>PVC</u> Dia. <u>5</u> Slot/gauze <u>1/32</u> Length <u>8'</u> Set between <u>184</u> ft. and <u>192</u> ft. Gravel pack? <input checked="" type="checkbox"/> Size range of material <u>1/8-1/4</u>	
11. Static water level: <u>114</u> ft. below land surface Date <u>8-18-76</u> mo./day/yr.	
12. Pumping level below land surfaces: <u>N/A</u> ft. after <input type="checkbox"/> hrs. pumping <input type="checkbox"/> g.p.m. Estimated maximum yield <u>30</u> g.p.m.	
13. Water sample submitted: <input checked="" type="checkbox"/> Yes <input type="checkbox"/> No Date	
14. Well head completion: <input checked="" type="checkbox"/> Pitless adapter <u>12</u> inches above grade	
15. Well grouted? <input checked="" type="checkbox"/> With: <input type="checkbox"/> Neat cement <input type="checkbox"/> Bentonite <input checked="" type="checkbox"/> Concrete Depth: From <u>0</u> ft. to <u>10</u> ft.	
16. Nearest source of possible contamination <u>none</u> ft. Direction Type Well disinfected upon completion? <input type="checkbox"/> Yes <input type="checkbox"/> No	
17. Pump: Not installed Manufacturer's name <u>REDA</u> Model number <u>10D18101</u> HP <u>1</u> Volts <u>220</u> Length of drop pipe <u>165</u> ft. capacity <u>18</u> g.p.m. Type: <input checked="" type="checkbox"/> Submersible <input type="checkbox"/> Turbine <input type="checkbox"/> Jet <input type="checkbox"/> Reciprocating <input type="checkbox"/> Centrifugal <input type="checkbox"/> Other	
18. Elevation: 19. Remarks: <u>BROCK 191'</u>	
20. Water well contractor's certification: This well was drilled under my jurisdiction and this report is true to the best of my knowledge and belief. Business name <u>STRUCKHOFF SONS 298</u> License No. Address <u>GRINNELL Ks</u> Signed <u>[Signature]</u> Date <u>9-21-76</u> Authorized representative	

Forward the white, blue and pink copies to the Department of Health and Environment

Form WWC-5