

USE TYPEWRITER OR BALL POINT PEN—PRESS FIRMLY, PRINT CLEARLY.

T R EW sec 1/4 1/4 1/4 No.


WATER WELL RECORD
KSA 82a-1201-1215

Kansas State Dept. Of Health
(Water Well Contractors)
Forbes-Bldg. 740
Topeka, Kansas 66620

AAA

1 Location of well: County Sheridan Township name NE-NE-NE Fraction 9 Section number 8 Town number 28 Range number

Distance and direction from nearest town or city: HOKI'E 3 Owner of well: Bob Geendes
Street address of well location if in city: 1N Address: HOKI'E

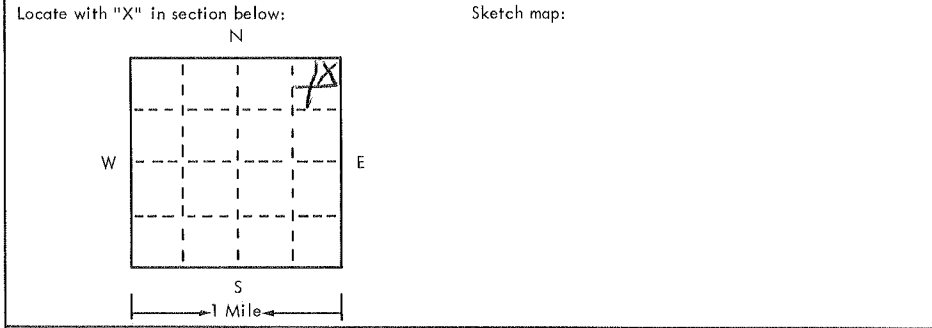

4 Well depth: 205 ft. Date of completion 9-23-77
Well diameter 9 in.
5 Cable tool Rotary Driven Dug
 Hollow rod Jetted Bored Reverse rotary
6 Use: Domestic Public supply Industry
 Irrigation Air conditioning Commercial
 Test well
7 Casing: Material PVC Height: above/below
Threaded Welded Surface 12 in.
Diam. _____ Weight _____ lbs./ft. _____
5 in. to 205 ft. depth Drive shoe? Yes No
_____ in. to _____ ft. depth

2	Type and color of material	From	To
	<u>top soil</u>	<u>0</u>	<u>27</u>
	<u>sandy clay</u>	<u>27</u>	<u>38</u>
	<u>m. gravel</u>	<u>38</u>	<u>59</u>
	<u>sandy clay</u>	<u>59</u>	<u>76</u>
	<u>m. gravel</u>	<u>76</u>	<u>85</u>
	<u>sandy clay & S.S.</u>	<u>85</u>	<u>136</u>
	<u>m. gravel</u>	<u>136</u>	<u>142</u>
	<u>fine sand</u>	<u>142</u>	<u>171</u>
	<u>m. gravel</u>	<u>171</u>	<u>176</u>
	<u>sandy clay</u>	<u>176</u>	<u>193</u>
	<u>gravel</u>	<u>193</u>	<u>201</u>
	<u>Other</u>	<u>201</u>	<u>205</u>
	<u>BROCK 201</u>		
	(use a second sheet if needed)		

8 Screen: Manufacturer Dees Howell
Type PVC Dia. _____
Slot/gauze 1/8 Length _____
Set between 193 ft. and 201 ft. _____
Fittings: Gravel pack Yes No Size range of material 1/8 x 1/4
9 Static water level: 95 ft. below land surface Date 9-23-77
10 Pumping level below land surfaces:
_____ ft. after _____ hrs. pumping _____ g.p.m.
_____ ft. after _____ hrs. pumping _____ g.p.m.
Estimated maximum yield 204 g.p.m.
11 Water sample submitted:
 Yes No Date _____
12 Well head completion: 12"
 Pitless adapter Inches above grade
13 Well grouted? Yes No
 Neat cement Bentonite
Depth: From 0 ft. to 14 ft.
14 Nearest source of possible contamination:
ft. _____ Direction _____ Type None
Well disinfected upon completion? Yes No
15 Pump: Not installed
Manufacturer's name _____
Model number _____ HP _____ Volts _____
Length of drop pipe _____ ft. capacity _____ g.m.p.
Type:
 Submersible Turbine
 Jet Reciprocating
 Centrifugal Other

16 Remarks: elevation

Topography:
 Hill
 Slope
 Upland
 Valley

17 Water well contractor's certification:
This well was drilled under my jurisdiction and this report is true to the best of my knowledge and belief.
STRUCKHOFF SONS 298
Business name License No.
Address STRUCKHOFF GRINNELL
Signed R. Struckhoff Date 9-30-77
Authorized representative

8 28W 9 NE NE NE