


1 LOCATION OF WATER WELL: Fraction SW 1/4 NE 1/4 Section Number 11 Township Number T 8 S Range Number R 28 EW

Distance and direction from nearest town or city street address of well if located within city?
 2 EAST 1 North of Hoxie

2 WATER WELL OWNER: Bernie Feldt
 RR#, St. Address, Box #: Rt. #1 Box 88B Board of Agriculture, Division of Water Resources
 City, State, ZIP Code: Hoxie, KS 67740 Application Number:

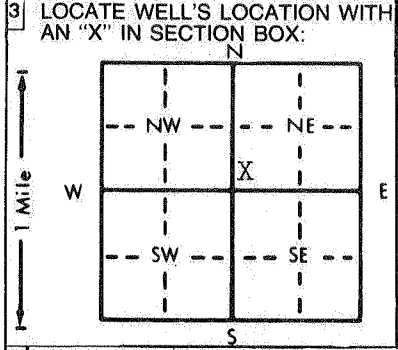

4 DEPTH OF COMPLETED WELL 185 ft. ELEVATION:
 Depth(s) Groundwater Encountered 1 ft. 2 ft. 3 ft.
 WELL'S STATIC WATER LEVEL 104 ft. below land surface measured on mo/day/yr 6-13-87
 Pump test data: Well water was ft. after hours pumping gpm
 Est. Yield gpm: Well water was ft. after hours pumping gpm
 Bore Hole Diameter 9 in. to 185 ft., and in. to ft.
 WELL WATER TO BE USED AS: 5 Public water supply 8 Air conditioning 11 Injection well
 1 Domestic 3 Feedlot 6 Oil field water supply 9 Dewatering 12 Other (Specify below)
 2 Irrigation 4 Industrial 7 Lawn and garden only 10 Observation well
 Was a chemical/bacteriological sample submitted to Department? Yes No X; If yes, mo/day/yr sample was submitted
 Water Well Disinfected? Yes X No

5 TYPE OF BLANK CASING USED:
 1 Steel 3 RMP (SR) 5 Wrought iron 8 Concrete tile CASING JOINTS: Glued X Clamped
 2 PVC 4 ABS 6 Asbestos-Cement 9 Other (specify below) Welded
 7 Fiberglass Threaded
 Blank casing diameter 5 in. to 165 ft., Dia. in. to ft., Dia. in. to ft.
 Casing height above land surface 12 in., weight 2.81 lbs./ft. Wall thickness or gauge No. 265
 TYPE OF SCREEN OR PERFORATION MATERIAL:
 1 Steel 3 Stainless steel 5 Fiberglass 7 PVC 10 Asbestos-cement
 2 Brass 4 Galvanized steel 6 Concrete tile 8 RMP (SR) 11 Other (specify)
 9 ABS 12 None used (open hole)
 SCREEN OR PERFORATION OPENINGS ARE:
 1 Continuous slot 5 Gauzed wrapped 8 Saw cut 11 None (open hole)
 2 Louvered shutter 3 Mill slot 6 Wire wrapped 9 Drilled holes
 4 Key punched 7 Torch cut 10 Other (specify)
 SCREEN-PERFORATED INTERVALS: From 165 ft. to 185 ft., From ft. to ft.
 GRAVEL PACK INTERVALS: From 25 ft. to 185 ft., From ft. to ft.

6 GROUT MATERIAL: 1 Neat cement 2 Cement grout 3 Bentonite 4 Other
 Grout intervals: From 5 ft. to 25 ft., From ft. to ft.
 What is the nearest source of possible contamination:
 1 Septic tank 4 Lateral lines 7 Pit privy 10 Livestock pens 14 Abandoned water well
 2 Sewer lines 5 Cess pool 8 Sewage lagoon 11 Fuel storage 15 Oil well/Gas well
 3 Watertight sewer lines 6 Seepage pit 9 Feedyard 12 Fertilizer storage 16 Other (specify below)
 13 Insecticide storage
 Direction from well? South How many feet? 150

| FROM | TO | LITHOLOGIC LOG | FROM | TO | LITHOLOGIC LOG |
|------|-----|----------------------|------|-----|---------------------|
| 0 | 3 | Surface | 169 | 175 | Fine to Medium Sand |
| 3 | 28 | Clay | 175 | 176 | Clay |
| 28 | 42 | Medium Sand | 176 | 181 | Medium Sand |
| 42 | 55 | Clay | 181 | 186 | Ochre |
| 55 | 64 | Medium Sand | 186 | 190 | Shale |
| 64 | 82 | Caliche | | | |
| 82 | 94 | Sandy Clay | | | |
| 94 | 107 | Caliche | | | |
| 107 | 124 | Medium Sand & Gravel | | | |
| 124 | 131 | Caliche | | | |
| 131 | 137 | Medium Sand | | | |
| 137 | 148 | Caliche | | | |
| 148 | 149 | Medium Sand | | | |
| 149 | 152 | Caliche | | | |
| 152 | 169 | Clay | | | |

7 CONTRACTOR'S OR LANDOWNER'S CERTIFICATION: This water well was (1) constructed, (2) reconstructed, or (3) plugged under my jurisdiction and was completed on (mo/day/year) 6-13-87 and this record is true to the best of my knowledge and belief. Kansas Water Well Contractor's License No. 394 This Water Well Record was completed on (mo/day/yr) 6-21-87 under the business name of Woofter Pump & Well by (signature) *Walter Woofter*

INSTRUCTIONS: Use typewriter or ball point pen. PLEASE PRESS FIRMLY and PRINT clearly. Please fill in blanks, underline or circle the correct answers. Send top three copies to Kansas Department of Health and Environment, Office of Oil Field and Environmental Geology, Regulation and Permitting Section, Topeka, Kansas 66620-7500, Telephone: 913-862-9360. Send one to WATER WELL OWNER and retain one for your records.