


1 LOCATION OF WATER WELL: Fraction NW 1/4 SW 1/4 SE 1/4 Section Number 11 Township Number T 8 S Range Number R 28

Distance and direction from nearest town or city street address of well if located within city?  
 One and onehalf mile east three-quarter north of Hoxie, Ks.

2 WATER WELL OWNER: Carl Gaede  
 RR#, St. Address, Box # : Rt. 1  
 City, State, ZIP Code : Hoxie, Ks. 67740  
 Board of Agriculture, Division of Water Resource  
 Application Number:

3 LOCATE WELL'S LOCATION WITH AN "X" IN SECTION BOX:

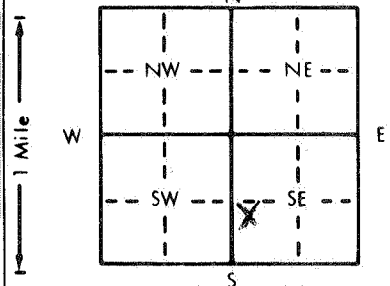

4 DEPTH OF COMPLETED WELL . . . . . 140 . . . . . ft. ELEVATION: . . . . .  
 Depth(s) Groundwater Encountered 1. . . . . ft. 2. . . . . ft. 3. . . . . ft.  
 WELL'S STATIC WATER LEVEL . 60 . . . . . ft. below land surface measured on mo/day/yr  
 Pump test data: Well water was . . . . . ft. after . . . . . hours pumping . . . . . gpm  
 Est. Yield . . . . . gpm: Well water was . . . . . ft. after . . . . . hours pumping . . . . . gpm  
 Bore Hole Diameter . 8 . . . . . in. to . . . . . 140 . . . . . ft., and . . . . . in. to . . . . . ft.  
 WELL WATER TO BE USED AS: 5 Public water supply 8 Air conditioning 11 Injection well  
 ① Domestic 3 Feedlot 6 Oil field water supply 9 Dewatering 12 Other (Specify below)  
 2 Irrigation 4 Industrial 7 Lawn and garden only 10 Monitoring well Stockwell  
 Was a chemical/bacteriological sample submitted to Department? Yes . . . . . No  . . . . .; If yes, mo/day/yr sample was submitted  
 Water Well Disinfected? Yes . . . . . No  . . . . .

5 TYPE OF BLANK CASING USED: 5 Wrought iron 8 Concrete tile CASING JOINTS: Glued  . . . . . Clamped . . . . .  
 1 Steel 3 RMP (SR) 6 Asbestos-Cement 9 Other (specify below) Welded . . . . .  
 2 PVC 4 ABS 7 Fiberglass . . . . . Threaded . . . . .

Blank casing diameter . . . . . 4.5 . . . . . in. to . . . . . 120 . . . . . ft., Dia . . . . . in. to . . . . . ft.  
 Casing height above land surface . . . . . 24 . . . . . in., weight . . . . . 2.38 . . . . . lbs./ft. Wall thickness or gauge No. . . . . 248

TYPE OF SCREEN OR PERFORATION MATERIAL: 7 PVC 10 Asbestos-cement  
 1 Steel 3 Stainless steel 5 Fiberglass 8 RMP (SR) 11 Other (specify)  
 2 Brass 4 Galvanized steel 6 Concrete tile 9 ABS 12 None used (open hole)

SCREEN OR PERFORATION OPENINGS ARE: 5 Gauzed wrapped 8 Saw cut 11 None (open hole)  
 1 Continuous slot 3 Mill slot 6 Wire wrapped 9 Drilled holes  
 2 Louvered shutter 4 Key punched 7 Torch cut 10 Other (specify)

SCREEN-PERFORATED INTERVALS: From . . . . . 120 . . . . . ft. to . . . . . 140 . . . . . ft., From . . . . . ft. to . . . . . ft.  
 GRAVEL PACK INTERVALS: From . . . . . 20 . . . . . ft. to . . . . . 140 . . . . . ft., From . . . . . ft. to . . . . . ft.

6 GROUT MATERIAL: 1 Neat cement 2 Cement grout 3 Bentonite 4 Other . . . . .  
 Grout Intervals: From . . . . . 0 . . . . . ft. to . . . . . 20 . . . . . ft., From . . . . . ft. to . . . . . ft., From . . . . . ft. to . . . . . ft.

What is the nearest source of possible contamination:  
 1 Septic tank 4 Lateral lines 7 Pit privy 10 Livestock pens 14 Abandoned water well  
 2 Sewer lines 5 Cess pool 8 Sewage lagoon 11 Fuel storage 15 Oil well/Gas well  
 3 Watertight sewer lines 6 Seepage pit 9 Feedyard 12 Fertilizer storage 16 Other (specify below)  
 13 Insecticide storage

Direction from well? W West How many feet? 600

FROM	TO	LITHOLOGIC LOG	FROM	TO	PLUGGING INTERVALS
0	3	Surface	105	117	Fine sand (tight) clay strk
3	9	Clay	117	128	Loose sand
9	20	Med. sand	128	129	Caliche
20	40	Fine sand with clay streaks	129	138	Fine loose sand
40	44	Clay	138	140	Ochre
44	46	Med. sand			
46	56	Clay & caliche			
56	76	Fine sand			
76	80	Cemented sand /caliche strks.			
80	85	Fine sand			
85	86	Caliche			
86	92	Fine sand			
92	99	Cemented sand			
99	105	Med. sand (loose)			

7 CONTRACTOR'S OR LANDOWNER'S CERTIFICATION: This water well was (1) constructed, (2) reconstructed, or (3) plugged under my jurisdiction and was completed on (mo/day/year) . . . . . 2-26-90 . . . . . and this record is true to the best of my knowledge and belief. Kansas Water Well Contractor's License No. . . . . 394 . . . . . This Water Well Record was completed on (mo/day/yr) . . . . . 2-27-90 . . . . . under the business name of WOOFER PUMP & WELL by (signature) Walter Woofler