


WATER WELL RECORD Form WWC-5 KSA 82a-1212

1 LOCATION OF WATER WELL: Fraction SE 1/4 SW 1/4 NE 1/4 Section Number 16 Township Number T 8 S Range Number R 28 EW

Distance and direction from nearest town or city street address of well if located within city?
1 mile west of 23 & 24 Highway Hoxie, Ks.

2 WATER WELL OWNER: City of Hoxie, Ks.
RR#, St. Address, Box # : Board of Agriculture, Division of Water Resource
City, State, ZIP Code : Application Number: 26510

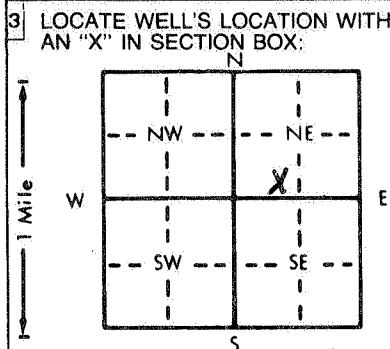

4 DEPTH OF COMPLETED WELL... 190... ft. ELEVATION: ...
Depth(s) Groundwater Encountered 1... ft. 2... ft. 3... ft.
WELL'S STATIC WATER LEVEL... 102... ft. below land surface measured on mo/day/yr
Pump test data: Well water was ... ft. after ... hours pumping ... gpm
Est. Yield ... gpm: Well water was ... ft. after ... hours pumping ... gpm
Bore Hole Diameter... 30... in. to ... ft., and... in. to ... ft.
WELL WATER TO BE USED AS: 5 Public water supply 8 Air conditioning 11 Injection well
1 Domestic 3 Feedlot 6 Oil field water supply 9 Dewatering 12 Other (Specify below)
2 Irrigation 4 Industrial 7 Lawn and garden only 10 Monitoring well
Was a chemical/bacteriological sample submitted to Department? Yes... No...
Water Well Disinfected? Yes... No

5 TYPE OF BLANK CASING USED: 1 Steel 3 RMP (SR) 5 Wrought iron 8 Concrete tile CASING JOINTS: Glued... Clamped...
2 PVC 4 ABS 6 Asbestos-Cement 9 Other (specify below) Welded...
7 Fiberglass Threaded...
Blank casing diameter... 16... in. to 150... ft., Dia... in. to ... ft., Dia... in. to ... ft.
Casing height above land surface... 30... in., weight... 19.75... lbs./ft. Wall thickness or gauge No. ... 616
TYPE OF SCREEN OR PERFORATION MATERIAL: 7 PVC 10 Asbestos-cement
1 Steel 3 Stainless steel 5 Fiberglass 8 RMP (SR) 11 Other (specify)
2 Brass 4 Galvanized steel 6 Concrete tile 9 ABS 12 None used (open hole)
SCREEN OR PERFORATION OPENINGS ARE: 5 Gauzed wrapped 8 Saw cut 11 None (open hole)
1 Continuous slot 3 Mill slot 6 Wire wrapped 9 Drilled holes
2 Louvered shutter 4 Key punched 7 Torch cut 10 Other (specify)
SCREEN-PERFORATED INTERVALS: From... 150... ft. to ... 190... ft., From... ft. to... ft.
GRAVEL PACK INTERVALS: From... 20... ft. to ... 190... ft., From... ft. to... ft.

6 GROUT MATERIAL: 1 Neat cement 2 Cement grout 3 Bentonite 4 Other
Grout Intervals: From... 0... ft. to ... 20... ft., From... ft. to... ft., From... ft. to... ft.
What is the nearest source of possible contamination: 10 Livestock pens 14 Abandoned water well
1 Septic tank 4 Lateral lines 7 Pit privy 11 Fuel storage 15 Oil well/Gas well
2 Sewer lines 5 Cess pool 8 Sewage lagoon 12 Fertilizer storage 16 Other (specify below)
3 Watertight sewer lines 6 Seepage pit 9 Feedyard 13 Insecticide storage
Direction from well? South How many feet? 25

FROM	TO	LITHOLOGIC LOG	FROM	TO	PLUGGING INTERVALS
0	3	Surface	111	117	Med. sand
3	38	Clay	117	125	Caliche (hard)
38	56	Med. loose sand sm. clay stk.	125	147	Med. sand, caliche ledge
56	63	Clay, small sand streaks	147	154	Clay
63	64	Clay & caliche	154	155	Fine sand
64	78	Clay	155	158	Clay
78	79	Caliche	158	163	Med. loose sand, fine sand
79	80	Clay	163	172	Clay & sandy clay
80	86	Rocky sand & caliche	172	185	Fine to med. sand
86	89	Med. sand	185	190	Ochre & shale
89	92	Clay			
92	95	Caliche & sand			
95	97	Caliche			
97	106	Med. sand /small caliche strk.			
106	111	Med. sand/hard caliche strk.			

7 CONTRACTOR'S OR LANDOWNER'S CERTIFICATION: This water well was (1) constructed, (2) reconstructed, or (3) plugged under my jurisdiction and was completed on (mo/day/year) 7-25-91 and this record is true to the best of my knowledge and belief. Kansas Water Well Contractor's License No. 394. This Water Well Record was completed on (mo/day/yr) 8-2-91 under the business name of WOOFTER PUMP & WELL by (signature) Walter Woofter

INSTRUCTIONS: Use typewriter or ball point pen. PLEASE PRESS FIRMLY and PRINT clearly. Please fill in blanks, underline or circle the correct answers. Send top three copies to Kansas Department of Health and Environment, Bureau of Water, Topeka, Kansas 66620-0001. Telephone: 913-296-5545. Send one to WATER WELL OWNER and retain one for your records.