


1 LOCATION OF WATER WELL: Fraction C 1/4 S 1/2 1/4 SW 1/4 Section Number 26 Township Number T 8 S Range Number R 28 EW

Distance and direction from nearest town or city street address of well if located within city?
 2 south 1 1/2 east of Hoxie, Ks.

2 WATER WELL OWNER: Vic Bielser
 RR#, St. Address, Box # :
 City, State, ZIP Code : Hoxie, Ks. 67740
 Board of Agriculture, Division of Water Resources
 Application Number:

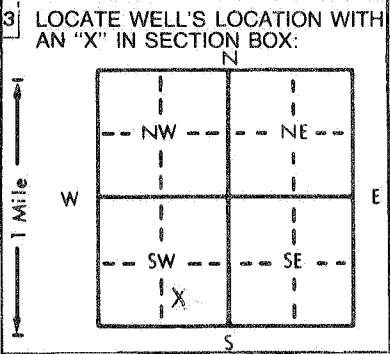

4 DEPTH OF COMPLETED WELL... 160 ft. ELEVATION:
 Depth(s) Groundwater Encountered 1. ft. 2. ft. 3. ft.
 WELL'S STATIC WATER LEVEL ft. below land surface measured on mo/day/yr
 Pump test data: Well water was ft. after hours pumping gpm
 Est. Yield gpm: Well water was ft. after hours pumping gpm
 Bore Hole Diameter ... 8 ... in. to 160 ... ft., and ... in. to ... ft.
 WELL WATER TO BE USED AS: 5 Public water supply 8 Air conditioning 11 Injection well
 1 Domestic 3 Feedlot 6 Oil field water supply 9 Dewatering 12 Other (Specify below)
 2 Irrigation 4 Industrial 7 Lawn and garden only 10 Monitoring well
 Was a chemical/bacteriological sample submitted to Department? Yes.....No.X.....; If yes, mo/day/yr sample was submitted
 Water Well Disinfected? Yes No X

5 TYPE OF BLANK CASING USED: 5 Wrought iron 8 Concrete tile CASING JOINTS: Glued X Clamped
 1 Steel 3 RMP (SR) 6 Asbestos-Cement 9 Other (specify below) Welded
 2 PVC 4 ABS 7 Fiberglass Threaded
 Blank casing diameter ... 4.5 ... in. to 140 ... ft., Dia ... in. to ... ft., Dia ... in. to ... ft.
 Casing height above land surface ... 24 ... in., weight ... 2.38 ... lbs./ft. Wall thickness or gauge No.
 TYPE OF SCREEN OR PERFORATION MATERIAL: 7 PVC 10 Asbestos-cement .248
 1 Steel 3 Stainless steel 5 Fiberglass 8 RMP (SR) 11 Other (specify)
 2 Brass 4 Galvanized steel 6 Concrete tile 9 ABS 12 None used (open hole)
 SCREEN OR PERFORATION OPENINGS ARE: 5 Gauzed wrapped 8 Saw cut 11 None (open hole)
 1 Continuous slot 3 Mill slot 6 Wire wrapped 9 Drilled holes
 2 Louvered shutter 4 Key punched 7 Torch cut 10 Other (specify)
 SCREEN-PERFORATED INTERVALS: From ... 140 ... ft. to ... 160 ... ft., From ... ft. to ... ft.
 GRAVEL PACK INTERVALS: From ... 20 ... ft. to ... 160 ... ft., From ... ft. to ... ft.

6 GROUT MATERIAL: 1 Neat cement 2 Cement grout 3 Bentonite 4 Other
 Grout Intervals: From ... 0 ... ft. to ... 20 ... ft., From ... ft. to ... ft., From ... ft. to ... ft.
 What is the nearest source of possible contamination:
 1 Septic tank 4 Lateral lines 7 Pit privy 10 Livestock pens 14 Abandoned water well
 2 Sewer lines 5 Cess pool 8 Sewage lagoon 11 Fuel storage 15 Oil well/Gas well
 3 Watertight sewer lines 6 Seepage pit 9 Feedyard 12 Fertilizer storage 16 Other (specify below)
 13 Insecticide storage

Direction from well? How many feet?

FROM	TO	LITHOLOGIC LOG	FROM	TO	PLUGGING INTERVALS
0	3	Surface	85	88	Clay
3	15	Clay with sand streaks	88	90	Cemented sand
15	19	Sand (fine to med.)	90	97	Med. sand (very loose)
19	21	Clay	97	100	White clay & caliche
21	34	Med. sand	100	108	Med. sand (loose)
34	38	Clay with sand streaks	108	115	Sand with caliche streaks
38	48	Sand (large)	115	124	Clay
48	57	Clay	124	127	Fine to med. sand/clay strk.
57	59	Calikche & cemented sand	127	134	Clay
59	70	Fine to med. sand /clay strk.	134	153	Med. sand
70	77	Sand with caliche streaks	153	155	Clay
77	78	Clay	155	158	Med. to large sand
78	79	Med. sand	159	160	Ochre & shale
79	81	Caliche			
81	85	Cemented sand			

7 CONTRACTOR'S OR LANDOWNER'S CERTIFICATION: This water well was (1) constructed, (2) reconstructed, or (3) plugged under my jurisdiction and was completed on (mo/day/year) ... 8-13-91 ... and this record is true to the best of my knowledge and belief. Kansas Water Well Contractor's License No. ... 394 ... This Water Well Record was completed on (mo/day/yr) ... 8-14-91 ... under the business name of WOOFER PUMP & WELL by (signature) *Walter Woolfe*