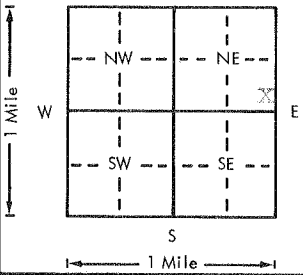


USE TYPEWRITER OR BALL POINT PEN-PRESS FIRMLY, PRINT CLEARLY.

ADD
WATER WELL RECORD
KSA 82a-1201-1215

Kansas Department of Health and Environment-Division of Environment (Water well Contractors) Topeka, Kansas 66620

1. Location of well: County <u>Sheridan</u>		X Section <u>SE</u> <u>NE</u> SE 1/4 NE 1/4		Section number <u>28</u>	Township number <u>8</u>	Range number <u>28</u>
2. Distance and direction from nearest town or city: <u>1 1/2 M S. of Hoxie</u> Street address of well location if in city:				3. Owner of well: <u>John Tebo Impl.</u> R.R. or street: <u>So. Hiway 23</u> City, state, zip code: <u>Hoxie, Kansas 67740</u>		
X Locate with "X" in section below: N W E S 1 Mile 1 Mile		Sketch map: 		6. Bore hole dia. <u>8</u> in. Completion date _____ Well depth <u>200</u> ft. <u>8-19-76</u>		
5. Type and color of material		From	To	7. Cable tool <input checked="" type="checkbox"/> Rotary <input type="checkbox"/> Driven <input type="checkbox"/> Dug <input type="checkbox"/> Hollow rod <input type="checkbox"/> Jetted <input type="checkbox"/> Bored <input type="checkbox"/> Reverse rotary		
Top Soil		0	47	8. Use: <input type="checkbox"/> Domestic <input type="checkbox"/> Public supply <input checked="" type="checkbox"/> Industry <input type="checkbox"/> Irrigation <input type="checkbox"/> Air conditioning <input type="checkbox"/> Stock <input type="checkbox"/> Lawn <input type="checkbox"/> Oil field water <input type="checkbox"/> Other		
Sand		47	49	9. Casing: Material <u>plst</u> Height: Above or below Threaded <input type="checkbox"/> Welded <input type="checkbox"/> Surface <u>15</u> in. RMP <input checked="" type="checkbox"/> PVC <input type="checkbox"/> Weight _____ lbs./ft. Dia. <u>5</u> in. to <u>200</u> ft. depth Wall Thickness: inches or Dia. _____ in. to _____ ft. depth gage No. <u>1/4</u>		
Sand and Sandy Clay Strips		49	114	10. Screen: Manufacturer's name _____ <u>J and L</u>		
Sand		114	144	Type <u>RMP</u> Dia. <u>5"</u> Slot/gauze <u>7/8" 1/32"</u> Length <u>10'</u> Set between <u>180</u> ft. and <u>200</u> ft. _____ ft. and _____ ft. Gravel pack? <u>yes</u> Size range of material <u>1/8"</u>		
Sand Rock		144	151	11. Static water level: _____ mo./day/yr. <u>85</u> ft. below land surface Date _____		
Sand		151	161	12. Pumping level below land surfaces: _____ ft. after <u>NA</u> hrs. pumping _____ g.p.m. _____ ft. after _____ hrs. pumping _____ g.p.m. Estimated maximum yield _____ g.p.m.		
Sand and Sand Rock Strips		161	192	13. Water sample submitted: _____ mo./day/yr. Yes <input type="checkbox"/> No <input checked="" type="checkbox"/> Date _____		
Oker		192	200	14. Well head completion: <u>no</u> Pitless adapter _____ Inches above grade		
ROCK 192'				15. Well grouted? <u>yes</u> With: <input type="checkbox"/> Neat cement <input checked="" type="checkbox"/> Bentonite <input type="checkbox"/> Concrete Depth: From <u>4</u> ft. to <u>49</u> ft.		
				16. Nearest source of possible contamination: ft. _____ Direction <u>none</u> Type _____ Well disinfected upon completion? <input checked="" type="checkbox"/> Yes <input type="checkbox"/> No		
				17. Pump: <input checked="" type="checkbox"/> Not installed Manufacturer's name _____ Model number _____ HP _____ Volts _____ Length of drop pipe _____ ft. capacity _____ g.p.m. Type: <input type="checkbox"/> Submersible <input type="checkbox"/> Turbine <input type="checkbox"/> Jet <input type="checkbox"/> Reciprocating <input type="checkbox"/> Centrifugal <input type="checkbox"/> Other		
				20. Water well contractor's certification: This well was drilled under my jurisdiction and this report is true to the best of my knowledge and belief. <u>Bartell Drilling</u> Business name License No. _____ Address <u>Winona, Kansas 67764</u> Signed <u>Joyce Bartell</u> Date <u>11/77</u> Authorized representative		
18. Elevation:		19. Remarks:				
Topography: <input type="checkbox"/> Hill <input type="checkbox"/> Slope <input checked="" type="checkbox"/> Upland <input type="checkbox"/> Valley						

Forward the white, blue and pink copies to the Department of Health and Environment

Form WWC-5

T
8
28
W
28
E
28
S
SE
SE
SE
SE
1/4
1/4
1/4