


1 LOCATION OF WATER WELL: Fraction NW 1/4 NE 1/4 SW 1/4 Section Number 14 Township Number T 8 S Range Number R 28 **EW**

Distance and direction from nearest town or city street address of well if located within city?
 1 Mile East of Hoxie, Ks.

2 WATER WELL OWNER: Scott Schippers
 RR#, St. Address, Box # :
 City, State, ZIP Code : Hoxie, Ks. 67740
 Board of Agriculture, Division of Water Resources
 Application Number:

3 LOCATE WELL'S LOCATION WITH AN "X" IN SECTION BOX:

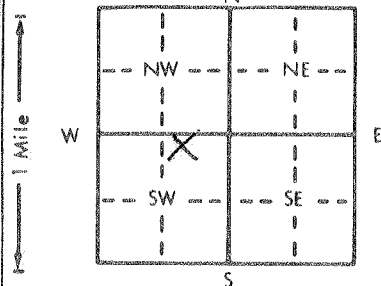

4 DEPTH OF COMPLETED WELL... 130 ft. ELEVATION: ...
 Depth(s) Groundwater Encountered 1. ft. 2. ft. 3. ft.
 WELL'S STATIC WATER LEVEL ... 52 ft. below land surface measured on mo/day/yr
 Pump test data: Well water was ft. after hours pumping gpm
 Est. Yield gpm: Well water was ft. after hours pumping gpm
 Bore Hole Diameter ... 8 in. to ... 130 ft., and ... in. to ... ft.
 WELL WATER TO BE USED AS: 5 Public water supply 8 Air conditioning 11 Injection well
 1 Domestic 3 Feedlot 6 Oil field water supply 9 Dewatering 12 Other (Specify below)
 2 Irrigation 4 Industrial 7 Lawn and garden only 10 Monitoring well
 Was a chemical/bacteriological sample submitted to Department? Yes.....No...**X**.....; If yes, mo/day/yr sample was submitted
 Water Well Disinfected? Yes No **X**

5 TYPE OF BLANK CASING USED: 5 Wrought iron 8 Concrete tile CASING JOINTS: Glued ..**X**.. Clamped ..
 1 Steel 3 RMP (SR) 6 Asbestos-Cement 9 Other (specify below) Welded ..
 2 PVC 4 ABS 7 Fiberglass Threaded ..
 Blank casing diameter ... 4.5 in. to ... 110 ft., Dia ... in. to ... ft., Dia ... in. to ... ft.
 Casing height above land surface ... 18 in., weight ... 2.38 lbs./ft. Wall thickness or gauge No. ... 248
 TYPE OF SCREEN OR PERFORATION MATERIAL: 7 PVC 10 Asbestos-cement
 1 Steel 3 Stainless steel 5 Fiberglass 8 RMP (SR) 11 Other (specify) ..
 2 Brass 4 Galvanized steel 6 Concrete tile 9 ABS 12 None used (open hole)
 SCREEN OR PERFORATION OPENINGS ARE: 5 Gauzed wrapped 8 Saw cut 11 None (open hole)
 1 Continuous slot 3 Mill slot 6 Wire wrapped 9 Drilled holes
 2 Louvered shutter 4 Key punched 7 Torch cut 10 Other (specify) ..
 SCREEN-PERFORATED INTERVALS: From ... 110 ft. to ... 130 ft., From ... ft. to ... ft.
 From ... ft. to ... ft., From ... ft. to ... ft.
 GRAVEL PACK INTERVALS: From ... 20 ft. to ... 130 ft., From ... ft. to ... ft.
 From ... ft. to ... ft., From ... ft. to ... ft.

6 GROUT MATERIAL: 1 Neat cement 2 Cement grout 3 Bentonite 4 Other ..
 Grout Intervals: From ... 0 ft. to ... 20 ft., From ... ft. to ... ft., From ... ft. to ... ft.
 What is the nearest source of possible contamination:
 1 Septic tank 4 Lateral lines 7 Pit privy 10 Livestock pens 14 Abandoned water well
 2 Sewer lines 5 Cess pool 8 Sewage lagoon 11 Fuel storage 15 Oil well/Gas well
 3 Watertight sewer lines 6 Seepage pit 9 Feedyard 12 Fertilizer storage 16 Other (specify below)
 13 Insecticide storage **NONE**

FROM	TO	LITHOLOGIC LOG	FROM	TO	PLUGGING INTERVALS
0	4	Surface			
4	11	Clay			
11	35	Fine Med. Sand w/Clay Strks.			
35	43	Sandy Clay			
43	46	Caliche			
46	77	Fine Med. Sand			
77	87	Silty Fine Sand			
87	92	Caliche & Clay			
92	97	Sandy Clay w/Sand & Caliche St			
97	102	Sticky Clay			
102	118	Fine Sand w/Clay Strks.			
118	127	Med. Coarse Sand & Gravel			
127	130	Ochre			

7 CONTRACTOR'S OR LANDOWNER'S CERTIFICATION: This water well was (1) constructed, (2) reconstructed, or (3) plugged under my jurisdiction and was completed on (mo/day/year) ... 12-16-94 ... and this record is true to the best of my knowledge and belief. Kansas Water Well Contractor's License No. ... 554 ... This Water Well Record was completed on (mo/day/yr) ... 12-17-94 ... under the business name of **Woofter Pump & Well, Inc.** by (signature) *July G. Woofter*

INSTRUCTIONS: Use typewriter or ball point pen. PLEASE PRESS FIRMLY and PRINT clearly. Please fill in blanks, underline or circle the correct answers. Send top three copies to Kansas Department of Health and Environment, Bureau of Water, Topeka, Kansas 66620-0001. Telephone: 913-296-5545. Send one to WATER WELL OWNER and retain one for your records.