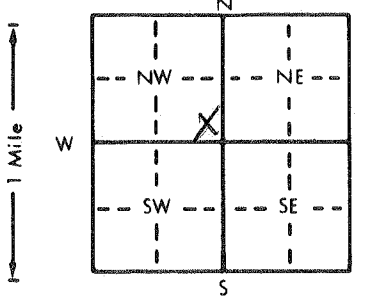


1 LOCATION OF WATER WELL: Fraction Section Number Township Number Range Number  
 County: Sheridan SE 1/4 SE 1/4 NW 1/4 1 T 8 S R 29 EW

Distance and direction from nearest town or city street address of well if located within city?

2 WATER WELL OWNER: Archie Moss  
 RR#, St. Address, Box #: Rt. 1 Box 99C Board of Agriculture, Division of Water Resources  
 City, State, ZIP Code: Hoxie, Ks. 67740 Application Number: 4481

3 LOCATE WELL'S LOCATION WITH AN "X" IN SECTION BOX:  
  
 4 DEPTH OF COMPLETED WELL: 248 ft. ELEVATION:  
 Depth(s) Groundwater Encountered 1. 156 ft. 2. ft. 3. ft.  
 WELL'S STATIC WATER LEVEL 156 ft. below land surface measured on mo/day/yr  
 Pump test data: Well water was ft. after hours pumping gpm  
 Est. Yield gpm: Well water was ft. after hours pumping gpm  
 Bore Hole Diameter 30 in. to 248 ft. and in. to ft.  
 WELL WATER TO BE USED AS:  
 5 Public water supply 8 Air conditioning 11 Injection well  
 1 Domestic 3 Feedlot 6 Oil field water supply 9 Dewatering 12 Other (Specify below)  
 2 Irrigation 4 Industrial 7 Lawn and garden only 10 Monitoring well  
 Was a chemical/bacteriological sample submitted to Department? Yes No X; If yes, mo/day/yr sample was submitted  
 Water Well Disinfected? Yes No X

5 TYPE OF BLANK CASING USED:  
 1 Steel 3 RMP (SR) 5 Wrought iron 8 Concrete tile CASING JOINTS: Glued X Clamped  
 2 PVC 4 ABS 6 Asbestos-Cement 9 Other (specify below) Welded  
 7 Fiberglass Threaded  
 Blank casing diameter 16 in. to 148 ft. Dia in. to ft. Dia in. to ft.  
 Casing height above land surface 24 in., weight 16.150 lbs./ft. Wall thickness or gauge No. 500  
 TYPE OF SCREEN OR PERFORATION MATERIAL:  
 1 Steel 3 Stainless steel 5 Fiberglass 7 PVC 10 Asbestos-cement  
 2 Brass 4 Galvanized steel 6 Concrete tile 8 RMP (SR) 11 Other (specify)  
 12 None used (open hole)  
 SCREEN OR PERFORATION OPENINGS ARE:  
 1 Continuous slot 3 Mill slot 5 Gauzed wrapped 8 Saw cut 11 None (open hole)  
 2 Louvered shutter 4 Key punched 6 Wire wrapped 9 Drilled holes  
 7 Torch cut 10 Other (specify)  
 SCREEN-PERFORATED INTERVALS: From 148 ft. to 248 ft. From ft. to ft.  
 GRAVEL PACK INTERVALS: From 20 ft. to 248 ft. From ft. to ft.

6 GROUT MATERIAL: 1 Neat cement 2 Cement grout 3 Bentonite 4 Other  
 Grout Intervals: From 0 ft. to 20 ft. From ft. to ft. From ft. to ft.  
 What is the nearest source of possible contamination: NONE 10 Livestock pens 14 Abandoned water well  
 1 Septic tank 4 Lateral lines 7 Pit privy 11 Fuel storage 15 Oil well/Gas well  
 2 Sewer lines 5 Cess pool 8 Sewage lagoon 12 Fertilizer storage 16 Other (specify below)  
 3 Watertight sewer lines 6 Seepage pit 9 Feedyard 13 Insecticide storage

Direction from well? How many feet?

FROM	TO	LITHOLOGIC LOG	FROM	TO	PLUGGING INTERVALS
0	2	Surface	160	167	Caliche & Cemented Sand
2	20	Loess	167	174	Med. Sand w/Cemented Strks.
20	34	Sandy Clay & Caliche	174	177	Cemented Sand
34	40	Med. Sand w/Clay Strks.	177	180	Med. Sand w/Clay & Cemented S
40	65	Med. Sand & Gravel w/Clay Str	180	193	Cemented Sand w/Clay Lenses
65	77	Sandy Clay & Caliche w/S.Sand	193	204	Med. Sand w/Clay Strks.
77	82	Med. Sand & Gravel	204	207	Sandy Clay
82	85	Sandy Clay	207	210	Med. Sand
85	98	Med. Sand & Gravel w/Clay Str.	210	216	Med. Sand w/Clay Strks. &
98	100	Sandy Clay & Caliche w/S.Sand	216	219	Cem. Sand & Caliche Gravel
100	120	Sandy Clay & Fine Sand	219	222	Med. Sand & Gravel
120	133	Med. Sand w/a Few Clay Lns.	222	225	Sandy Clay
133	137	Cemented Sand w/Med. Sand Str	225	240	Med. Sand & Gravel w/Clay Ln
137	140	Med. Sand & Clay	240	250	Shale
140	160	Med. Sand & Gravel w/Clay Str.			

7 CONTRACTOR'S OR LANDOWNER'S CERTIFICATION: This water well was (1) constructed, (2) reconstructed, or (3) plugged under my jurisdiction and was completed on (mo/day/year) 11-20-95 and this record is true to the best of my knowledge and belief. Kansas Water Well Contractor's License No. 554. This Water Well Record was completed on (mo/day/yr) 11-22-95 under the business name of Woofter Pump & Well, Inc. by (signature) *Archie Moss*